LINCOLN
P36
4-6-72

MISSISSIPPI
BOARD OF WATER COMMISSIONERS
416 North State Street
Jackson, Mississippi 39201

CODED

WATER WELL DRILLERS LOG

6 April 1972 — STF Water Well — Lincoln
date well completed — firm name — county well located

LANDOWNER: E. R. Crosby
(mailing address)

WELL LOCATION:
sec. 3 T. 4 (N) R. 7 (E)
2 miles west of Bogue Chitto
(distance) (direction) (nearest town)

WELL PURPOSE:
(home, irrigation, municipal, industrial)

WELL COMPLETION DATA:

(1) diameter (inches) 4
(2) total depth (feet) 43
(3) static water level (feet) 15 below above top of ground.
(4) casing Pl (material), 37 (depth),
(size) if telescope see back.
(5) screen 6 (length), 37 (depth to top)
4 (size), Pl (material)
(6) pump 5 (HP) 8 (yield gpm)
elect (type power)
(7) electric log (yes or no)
(organization running log)
(8) how well bottom plugged Wood

DRILLERS REMARKS:

description of formations encountered	from	to
Clay	0	5
Sand Clay	5	20
Sand	20	43

CODED

JUN 16 1972
MISS. BD. OF
WATER COMM.

If well telescopes please sketch and show depths.

GROUND LEVEL

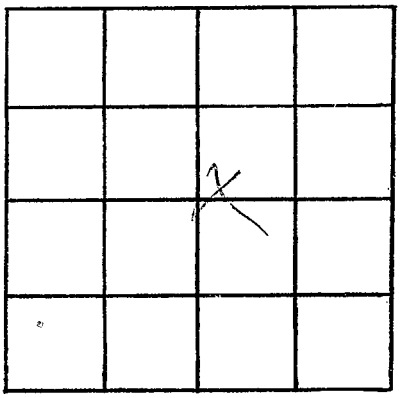

SECTION 3

Please indicate well location X.

ADDITIONAL INFORMATION

If more than one screen, show locations of each on sketch.