LINCOLN
P 37
4-20-72

MISSISSIPPI
BOARD OF WATER COMMISSIONERS
416 North State Street
Jackson, Mississippi 39201

CODED

WATER WELL DRILLERS LOG

20 April 1972 — S & P Water Well — Lincoln
date well completed — firm name — county well located

LANDOWNER: Renell Wallace

(mailing address)

WELL LOCATION:
sec. 33 T 5 N/S R 7 E/W

(distance) miles (direction) of (nearest town)

WELL PURPOSE:
(home, irrigation, municipal, industrial)

WELL COMPLETION DATA:

(1) diameter (inches) 4

(2) total depth (feet) 96

(3) static water level (feet) 20 below/above top of ground.

(4) casing Pl (material), 90 (depth),
(size) if telescope see back.

(5) screen 6 (length), 90 (depth to top)
4 (size), Pl (material)

(6) pump 1/2 (HP) 8 (yield gpm)
Elect (type power)

(7) electric log (yes or no)
(organization running log)

(8) how well bottom plugged wood

DRILLERS REMARKS:

description of formations encountered	from	to
Clay	0	15
Chalky clay	15	30
Sand chalky	30	50
Sand	50	65
Chalky Sand	65	75
Sand	75	96

CODED

JUN 16 1972
BOARD OF
CONTROL

If well telescopes please sketch and show depths.

GROUND LEVEL

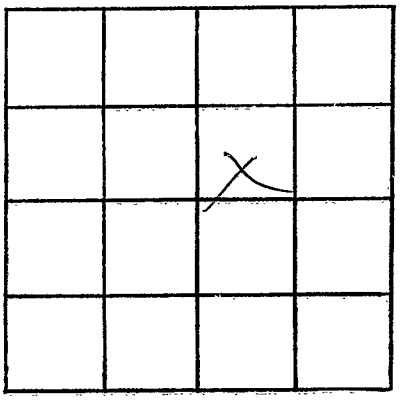

SECTION 33

Please indicate well location X.

ADDITIONAL INFORMATION

If more than one screen, show locations of each on sketch.