Lincoln
P
2054

MISSISSIPPI DEPARTMENT OF NATURAL RESOURCES

Bureau of Land and Water Resources
Southport Mall
P.O. Box 10631
Jackson, Mississippi 39209

WATER WELL DRILLERS LOG

9-20- 19 84 (date well completed) Grenn Water Well (firm name) Lincoln (county well located)

LANDOWNER: Leland Nichols

Rt. 3, Box 241

Bogue Chitto, Ms.
(mailing address)

WELL LOCATION:

sec. 7 T 5 N/S R 7 E/W

4 (distance) miles W (direction) of Bogue Chitto (nearest town)

WELL PURPOSE: home
(home, irrigation, municipal, industrial)

WELL COMPLETION DATA:

(1) diameter (inches) 4

(2) total depth (feet) 97

(3) static water level (feet) 44 below/above top of ground.

(4) casing PVC (material), 87' (depth),
4" (size) if telescope see back.

(5) screen 10' (length), 87' (depth to top)
.010 (size), PVC (material)

(6) pump 1/2 sub (HP) 8 (yield gpm)
electricity (type power)

(7) electric log no (yes or no)

(organization running log)

(8) how well bottom plugged back wash valve

DRILLERS REMARKS:

description of formations encountered	from	to
Citronelle	1	97

DEPT. OF NATURAL RESOURCES
BUREAU OF LAND & WATER RESOURCES
NOV 15 1984
RECEIVED

If well telescopes please sketch and show depths.

GROUND LEVEL

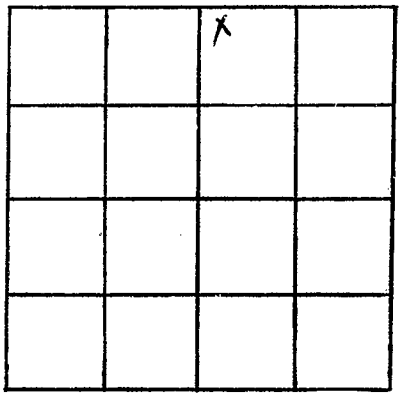

SECTION 7

Please indicate well location X.

ADDITIONAL INFORMATION

If more than one screen, show locations of each on sketch.