LINCOLN
P 2062

MISSISSIPPI DEPARTMENT OF NATURAL RESOURCES

Bureau of Land and Water Resources
Southport Mall
P.O. Box 10631
Jackson, Mississippi 39209

WATER WELL DRILLERS LOG

Oct 23 1986 Stafford Water Well Lincoln
date well completed firm name county well located

LANDOWNER: Nick Montalbano
Rt 4 Box 44 M R
Summit, Ms 39666
(mailing address)

WELL LOCATION:
sec. 35 T 5 (N/S) R 1 (E/W)
10 miles North of Northfield
(distance) (direction) (nearest town)

WELL PURPOSE: home
(home, irrigation, municipal, industrial)

WELL COMPLETION DATA:

(1) diameter (inches) 4"
(2) total depth (feet) 90'
(3) static water level (feet) 58 below/above top of ground.
(4) casing plastic (material), 90' (depth),
_____ (size) if telescope see back.
(5) screen 10' (length), 80' (depth to top)
4" (size), plastic (material)
(6) pump 5 (HP) 11 (yield gpm)
electric (type power)
(7) electric log _____ (yes or no)
_____ (organization running log)
(8) how well bottom plugged
Sand Snack

DRILLERS REMARKS:

description of formations encountered	from	to
Top Soil	0	6"
Red clay gravel	6"	45'
Red & White clay	45'	57'
Course sand & gravel	57'	90'

RECEIVED
NOV 12 1986
Department of Natural Resources
Bureau of Land & Water Resources

If well telescopes please sketch and show depths.

GROUND LEVEL

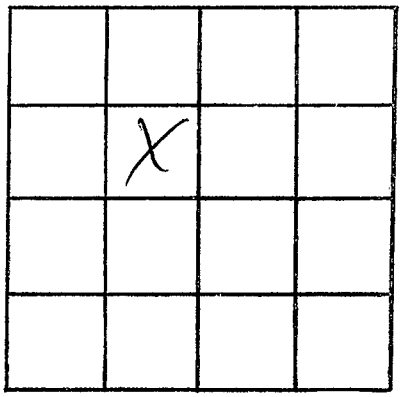

SECTION 35

Please indicate well location X.

ADDITIONAL INFORMATION

If more than one screen, show locations of each on sketch.