MISSISSIPPI DEPARTMENT OF NATURAL RESOURCES

Bureau of Land and Water Resources

P.O. Box 10631
Jackson, Mississippi 39209
WATER WELL DRILLERS LOG

COUNTY WELL LOCATED: LINCOLN

WELL NUMBER: P 2085 CODED

DATE WELL COMPLETED: 11-28-90

PERMIT NUMBER:

NAME OF DRILLING FIRM: Easley Water Well, Brandon MS 39601

NAME & MAILING ADDRESS OF LANDOWNER: Alda Hudson, Bouge Chitto, ~~Brookhaven, MS 39601~~, Lincoln

WELL LOCATION: SEC 28 TOWNSHIP 5 (N) S RANGE 7 (E) W

DISTANCE 4 Miles DIRECTION North of NEAREST TOWN Summit

OTHER LANDMARK:

WELL PURPOSE: Home, Irrigation, Municipal, Industrial, Fish Pond, etc.: Home

PUMP DATA

PUMP TYPE (Circle One): (Submersible) Turbine, Jet Flowing Well, Other (Describe) ½ HP

POWER TYPE (Circle One): Electric, Tractor, Diesel, Gasoline, Butane, Other (Describe)

Pump Capacity (GPM)	No. of Stages	Setting Depth
10	4	FT.

PUMP TEST

Well yielded _____ GPM with

a drawdown of _____ ft.

after _____ hours of pumping

WELL DATA

Well Depth	Casing Diameter (In.)	Casing Length (Ft.)
60'	4"	40'

Type of Casing	Hole Depth	Depth to Static Water Level
PVC	60'	

TYPE OF COMPLETION: (Circle One or More): Gravel Packed, Underreamed, Telescoped, (Natural Development) Open Hole, Other (Describe)

Top of Lap Pipe or Reduction in Casing: FEET

IF TELESCOPED OR MORE THAN ONE SCREEN: USE BACK PAGE

LOG DATA

TYPE OF LOG RUN (Circle One): (No Log Run) Electric, Gamma Ray, Density, Sonic, Neutron, Other (Describe)

Name of Organization Running Log

GEOLOGIC DATA (Office Use Only)

Surface Elev.	Geologic Unit	Unit Thickness	Depth to Top
Subs. SWL	Date	Analysis	Aquifer Test

Driller's Remarks

RECEIVED
JUN 7 199
Dept. of Environmental Quality
Bureau of Land & Water Resources

SCREEN DATA

Diameter - Inches	Length - Feet	Slot Size - Inches
4"	20'	0/10

Screen Type	Depth to Bottom - Feet
PVC	60'

DESCRIPTION OF FORMATIONS ENCOUNTERED	FROM	TO
Clay	0ft.	10ft.
Sand	10ft.	40ft.
Pea rocks	40ft.	60ft.

FORMATIONS (Continued)	FROM	TO

IF MORE SPACE IS NEEDED, USE BACK

If well telescopes please sketch and show depths.

GROUND LEVEL

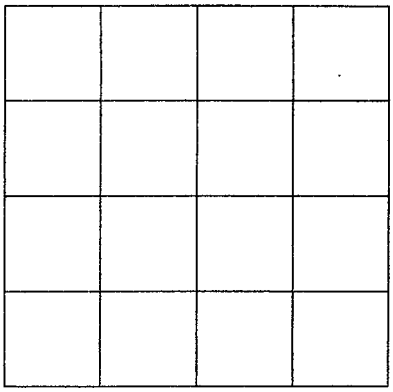

SECTION _____

Please indicate well location X.

ADDITIONAL INFORMATION

If more than one screen, show location of each on sketch.