Lincoln
Q 236

MISSISSIPPI DEPARTMENT OF NATURAL RESOURCES

Bureau of Land and Water Resources
Southport Mall
P.O. Box 10631
Jackson, Mississippi 39209

WATER WELL DRILLERS LOG

8-9 19 84 — date well completed
Grenn Water Well — firm name
Lincoln — county well located

LANDOWNER: C.B. Moak

Rt. 6

Brookhaven, Ms.
(mailing address)

WELL LOCATION:
sec. 30 T 5 N/S R 8 E/W

5 (distance) miles S (direction) of Bogue Chitto (nearest town)

WELL PURPOSE: home
(home, irrigation, municipal, industrial)

WELL COMPLETION DATA:

(1) diameter (inches) 4
(2) total depth (feet) 144
(3) static water level (feet) 60 below/above top of ground.
(4) casing PVC (material), 134' (depth),
4" (size) if telescope see back.
(5) screen 10' (length), 134' (depth to top)
.010 (size), PVC (material)
(6) pump 1/2 sub (HP) 8 (yield gpm)
electricity (type power)
(7) electric log no (yes or no)
(organization running log)
(8) how well bottom plugged
back wash valve

DRILLERS REMARKS:

description of formations encountered	from	to
Citronelle	1	144

DEPT. OF NATURAL RESOURCES
BUREAU OF LAND & WATER RESOURCES
SEP 18 1984
RECEIVED

If well telescopes please sketch and show depths.

GROUND LEVEL

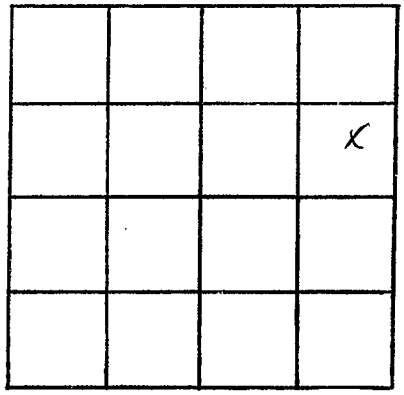

SECTION 30

Please indicate well location X.

ADDITIONAL INFORMATION

If more than one screen, show locations of each on sketch.