MISSISSIPPI DEPARTMENT OF NATURAL RESOURCES

Bureau of Land and Water Resources

P.O. Box 10631
Jackson, Mississippi 39209
WATER WELL DRILLERS LOG

COUNTY WELL LOCATED: Lincoln	
WELL NUMBER: P 2051	CODED
DATE WELL COMPLETED: 9/29/88	
PERMIT NUMBER:	
NAME OF DRILLING FIRM: Eagleye Water Well, Brookhaven, MS 39601	

NAME & MAILING ADDRESS OF LANDOWNER: Dan Barellone, Brookhaven, MS. 39601

WELL LOCATION:	SEC	TOWNSHIP	RANGE
Lincoln	3	5 (N) S	8 (E) W

DISTANCE	DIRECTION	NEAREST TOWN
15 Miles	SE	of Brookhaven

OTHER LANDMARK: 5 miles from Enterprise School

WELL PURPOSE: Home, Irrigation, Municipal, Industrial, Fish Pond, etc.: Home

PUMP DATA

PUMP TYPE (Circle One): Submersible, Turbine, Jet, Flowing Well, Other (Describe) no pump

POWER TYPE (Circle One): Electric, Tractor, Diesel, Gasoline, Butane, Other (Describe) _____ H/P _____

Pump Capacity (GPM)	No. of Stages	Setting Depth
		FT.

PUMP TEST

Well yielded _____ GPM with a drawdown of _____ ft. after _____ hours of pumping

WELL DATA

Well Depth	Casing Diameter (In.)	Casing Length (Ft.)
85 ft.	4 in.	75 ft.

Type of Casing	Hole Depth	Depth to Static Water Level
PVC #40	85 ft.	

TYPE OF COMPLETION: (Circle One or More): Gravel Packed, Underreamed, Telescoped, Natural Development, Open Hole, Other (Describe) _____

Top of Lap Pipe or Reduction in Casing: FEET

IF TELESCOPED OR MORE THAN ONE SCREEN: USE BACK PAGE

LOG DATA

TYPE OF LOG RUN (Circle One): No Log Run, Electric, Gamma Ray, Density, Sonic, Neutron, Other (Describe) _____

Name of Organization Running Log

GEOLOGIC DATA (Office Use Only)

Surface Elev.	Geologic Unit	Unit Thickness	Depth to Top
Subs. SWL	Date	Analysis	Aquifer Test

Driller's Remarks

SCREEN DATA

Diameter - Inches	Length - Feet	Slot Size - Inches
4 in.	10 ft.	0.10

Screen Type	Depth to Bottom - Feet
PVC	85 ft.

RECEIVED
APR 16 1990
Department of Natural Resources
Bureau of Land & Water Resources

DESCRIPTION OF FORMATIONS ENCOUNTERED	FROM	TO
Clay	0	10 ft.
Sand	10 ft.	40 ft.
Sand & gravel	40 ft.	66 ft.
Pea gravel	66 ft.	85 ft.

FORMATIONS (Continued)	FROM	TO

IF MORE SPACE IS NEEDED, USE BACK

If well telescopes please
sketch and show depths.

GROUND LEVEL

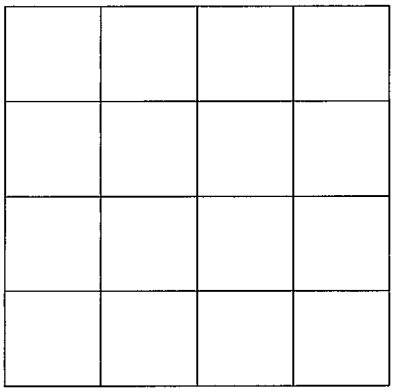

SECTION _____

Please indicate well location X.

ADDITIONAL INFORMATION

If more than one screen,
show location of each on sketch.