LINCOLN
R 2020
12-31-80

MISSISSIPPI
BOARD OF WATER COMMISSIONERS
416 North State Street
Jackson, Mississippi 39201

WATER WELL DRILLERS LOG

Dec. 31 19 80 Grenn Water Well Cont. Lincoln
date well completed — firm name — county well located

LANDOWNER: Clyde Burns
Route 1, Box 135
Ruth, Ms.
(mailing address)

WELL LOCATION:
sec. 3 T 5 (N/S) R 9 (E/W)
10 miles (distance) E (direction) of Bogue Chitto (nearest town)

WELL PURPOSE: home
(home, irrigation, municipal, industrial)

WELL COMPLETION DATA:
(1) diameter (inches) 4
(2) total depth (feet) 110
(3) static water level (feet) 66 below above top of ground.
(4) casing PVC (material), 100 (depth), 4" (size) if telescope see back.
(5) screen 10' (length), 100' (depth to top)
.010 (size), PVC (material)
(6) pump ½ sub (HP) 8 (yield gpm)
electricity (type power)
(7) electric log no (yes or no)
(organization running log)
(8) how well bottom plugged
back wash valve

DRILLERS REMARKS:

description of formations encountered	from	to
Citronelle	1	110

NATURAL RESOURCES
WATER RESOURCES
JAN 20 1981
RECEIVED

If well telescopes please sketch and show depths.

GROUND LEVEL

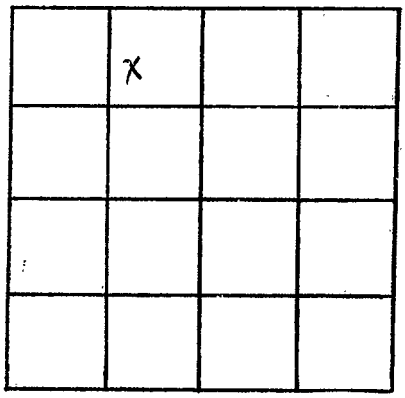

SECTION 3

Please indicate well location X.

ADDITIONAL INFORMATION

If more than one screen, show locations of each on sketch.