MISSISSIPPI DEPARTMENT OF NATURAL RESOURCES

Bureau of Land and Water Resources
Southport Mall
P.O. Box 10631
Jackson, Mississippi 39209

WATER WELL DRILLERS LOG

5-31 1983 Claudy Well Drilling
date well completed firm name county well located

LANDOWNER: _____

(mailing address)

WELL LOCATION:

sec. ____ T ____ N/S R ____ E/W

____ (distance) miles ____ (direction) of ____ (nearest town)

WELL PURPOSE: (home, irrigation, municipal, industrial)

WELL COMPLETION DATA:

(1) diameter (inches) _____

(2) total depth (feet) _____

(3) static water level (feet) _____ below/above top of ground.

(4) casing ____ (material), ____ (depth),

____ (size) if telescope see back.

(5) screen ____ (length), ____ (depth to top)

____ (size), ____ (material)

(6) pump ____ (HP) ____ (yield gpm)

____ (type power)

(7) electric log ____ (yes or no)

____ (organization running log)

(8) how well bottom plugged _____

DRILLERS REMARKS: _____

description of formations encountered	from	to
good sand	358	364
rock	364	
sand	364	366
rock 2"	366	
sand	366	367½
rock 3"	367½	
sand	367½	368½
rock 2"	368½	
sand	368½	371½
rock 6"	371½	372
sand	372	378
rock 3"	378	
sand	378	389
good sand	389	397
rock 2"	397	
gummy clay	397	400
good sand	400	407
gummy clay	407	409
#1 COLUMBUS AFB		
Parcel #1		
1687' N & 1538' W		
of SE/cor		

DEPT. OF NATURAL RESOURCES
BUREAU OF LAND & WATER RESOURCES
JUN 20 1983
RECEIVED

If well telescopes please sketch and show depths.

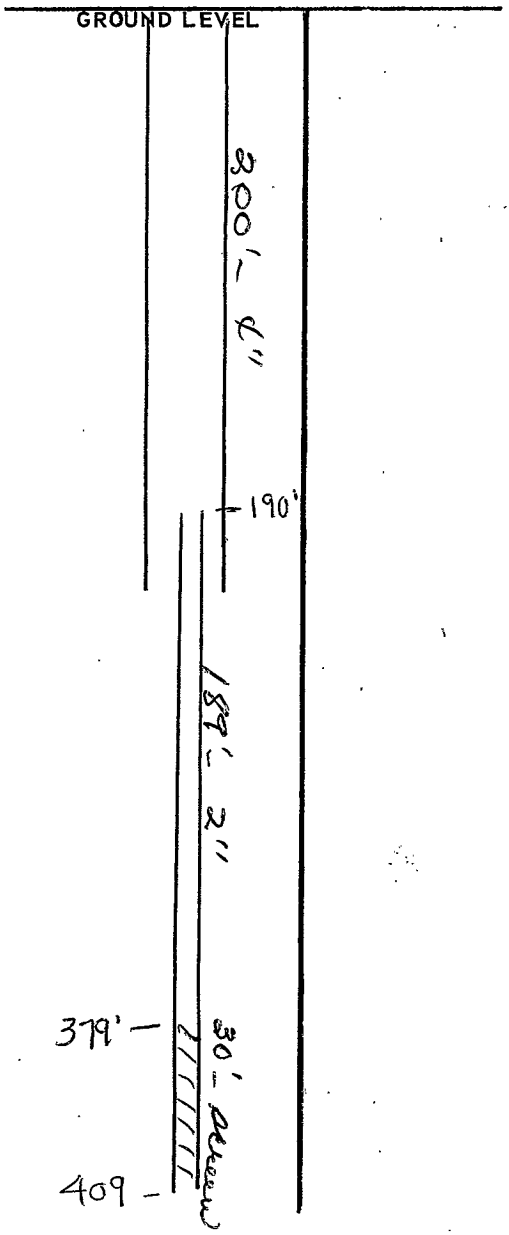

If more than one screen, show locations of each on sketch.

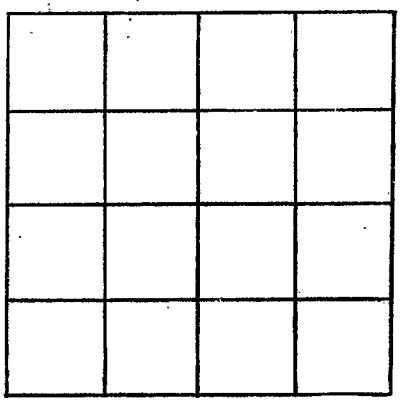

SECTION _____

Please indicate well location X.

ADDITIONAL INFORMATION