

OC82

7-15-61

WATER WELL DRILLERS LOG **CODED**

Date: 7-15, 1961, Driller: J C REEVES County LOWNDES
10325 (Name)

(1) Owner of Land: ALTON HONNELL
(Name)
COLUMBUS, MISS
RIDGE RD, 3288171 (Address)

(2) Location: SW SW SE 1/4, Sec. 34 T17R18N
2 miles N.E. of COLUMBUS
(distance) (direction) (Nearest Town)

(3) Topography: HILLY
(Hilly) (Flat) (Level)

(4) Purpose of Well: DOM
(Domestic, Irrigation, Municipal, Industrial, Other)

Description & Color of Materials Sand, Clay, Red. Clay, Shell, etc.	Thick- ness Feet	Depth Feet
<u>CLAY</u>	<u>22</u>	<u>0</u>
<u>RED SAND</u>	<u>176</u>	<u>22</u>
<u>BLUE CLAY</u>	<u>114</u>	<u>98</u>
<u>" SAND</u>	<u>17</u>	<u>212</u>
<u>" CLAY</u>	<u>19</u>	<u>229</u>
<u>1- SAND</u>	<u>37</u>	<u>248</u>

CODED

Information upon completion of well:

(1) Diameter 4 inches.

(2) Total Depth 285 feet.

(3) Water Level 70' feet below top of ground.

(4) Cased to 105', Size 4"


(5) Screen: Size _____, Length _____.

(6) Were any formations sealed against pollution?
_____ yes, _____ no.

If YES depth of formation _____

Why _____

Drillers Remarks: _____

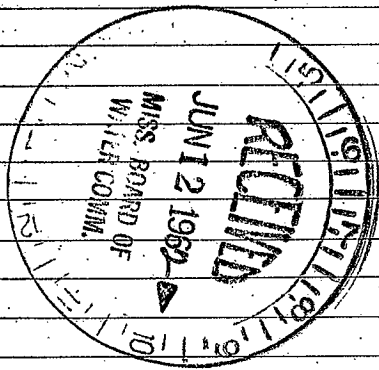

(Use Back Side)

Well No.

1921







