

LOWDES

C92

7-17-62

WATER WELL DRILLERS LOG

CODED

Date: 7-19, 1962, Driller: J. C. REEVES County: LOWDES

JESS LYONS RD - FROM 12 CROSS RR 1st (Name HOUSE OR TRAILER ON RT.)

(1) Owner of Land: ^{Changed} J. C. McCulloch (Name)
 COLUMBUS, MISS (Address)
 1105 11th St 3271930
 (2) Location: SW NE NE 1/4, 1/4, Sec. 26 T17R16Q
 5 miles N, of COLUMBUS, (distance) (direction) (Nearest Town)
 (3) Topography: FLAT (Hilly) (Flat) (Level)
 (4) Purpose of Well: TRAILER DOMESTIC (Domestic Irrigation Municipal; Industrial, Other)

Description & Color of Materials Sand, Clay, Red Clay, Shell, etc.	Thickness Feet	Depth Feet
RED CLAY	9	0
SAND & GRAVEL	16	9
BLUE CLAY	16	25
" SAND	12	41
" CLAY	5	53
" SAND	9	58
" CLAY	4	67
" SAND	19	71


CODED

Information upon completion of well:

(1) Diameter: 4 inches.
 (2) Total Depth: 90 feet.
 (3) Water Level: 9' feet below top of ground.
 (4) Cased to: 28 1/2', Size: 4"
 (5) Screen: Size _____, Length _____
 (6) Were any formations sealed against pollution?
 _____ yes, _____ no.

If YES depth of formation _____
 Why _____

Drillers Remarks: _____

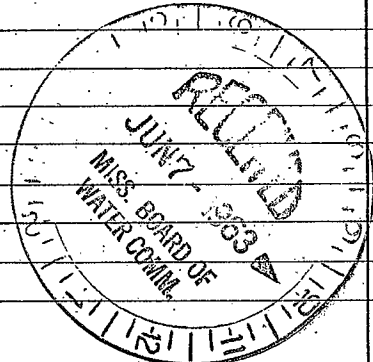

(Use Back Side)

Well No.










