Lowndes
C 2018

10-8-79

# MISSISSIPPI
# BOARD OF WATER COMMISSIONERS
416 North State Street
Jackson, Mississippi 39201

## WATER WELL DRILLERS LOG

Oct 8 19 79 MidSouth Drilling Co Lowndes
date well completed — firm name — county well located

LANDOWNER: Yakoa Plumbing
624 5th St.
Columbus MS 39701
(mailing address)

WELL LOCATION:
sec. 32 T 19 S R 18 W
2 (distance) miles N (direction) of Columbus (nearest town)

WELL PURPOSE: Home
(home, irrigation, municipal, industrial)

WELL COMPLETION DATA:

(1) diameter (inches) 4"

(2) total depth (feet) 315'

(3) static water level (feet) 70 below ~~above~~ top of ground.

(4) casing PVC (material), 160' (depth), 4" (size) If telescope see back.

(5) screen N/A (length) (depth to top)
(size), (material)

(6) pump 3/4 (HP) 10 (yield gpm)
electric (type power)

(7) electric log no (yes or no)
no (organization running log)

(8) how well bottom plugged open

DRILLERS REMARKS:

| description of formations encountered | from | to |
|---|---|---|
| Clay | 0 | 135 |
| Clay & sand | 135 | 160 |
| Clay | 160 | 165 |
| ~~165~~ Clay & sand | 165 | 315 |

DEPT. OF NATURAL RESOURCES
BUREAU OF LAND & WATER RESOURCES
JAN 7 1980
RECEIVED

If well telescopes please sketch and show depths.

GROUND LEVEL

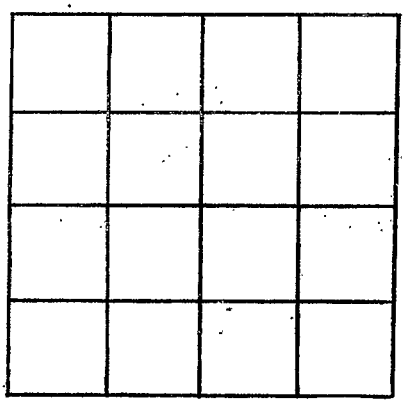

SECTION _____

Please indicate well location X.

ADDITIONAL INFORMATION

If more than one screen, show locations of each on sketch.