LOWNDES

~~LOWNDES~~

F66

log #56

MISSISSIPPI
BOARD OF WATER COMMISSIONERS
416 North State Street
Jackson, Mississippi 39201

CODED

WATER WELL DRILLERS LOG

Aug. 14, 1973 — date well completed
Herndon Well & Supply Co. — firm name
Lowndes — county well located

LANDOWNER: Universal Syrups, Inc. , Bpx 1013, Columbus, Miss.
(mailing address)

WELL LOCATION:
sec. 35 T 19 N/S R 17 E/W
1 miles (distance) S (direction) of hiway 82 (nearest town)

WELL PURPOSE: Industrial
(home, irrigation, municipal, industrial)

WELL COMPLETION DATA:

(1) diameter (inches) 10 X 6
(2) total depth (feet) 615
(3) static water level (feet) 49 below ~~above~~ top of ground.
(4) casing Steel (material), 550' (depth), 10" (size) if telescope see back.
(5) screen 60' (length), (depth to top), 6" (size), SS Wrapped (Ribbed) (material)
(6) pump 15 (HP) 10 GPF (yield gpm)
Elec. (type power)
(7) electric log yes (yes or no)
~~USGS~~ MBS (organization running log)
(8) how well bottom plugged 6" CI BW Valve

DRILLERS REMARKS:

description of formations encountered	from	to
Fill Dirt	0	14
Blue Rock	14	100
Tight Black sand & gumbo	100	200
Gumbo	200	230
Tight sand	230	290
Gumbo	290	320
Sand "Blue"	320	340
Dandy Gumbo	340	500
Good sand with Fine Grave	1500	620
Gumbo	620	630
Good sand	630	650
Tight sand	650	690

CODED

AUG 20 1973

(X)

10 X 6

If well telescopes please sketch and show depths.

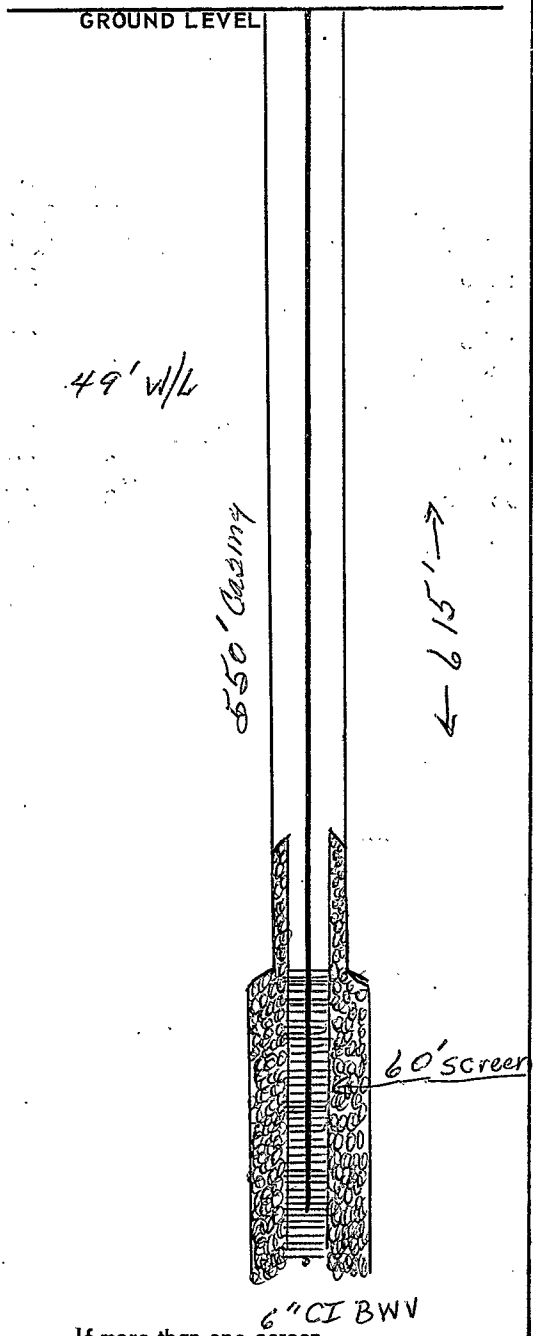

If more than one screen, show locations of each on sketch.

SECTION _____

Please indicate well location X.

ADDITIONAL INFORMATION