Federal Aviation Administration

F 67
LOWNDES
7-3-73

MISSISSIPPI BOARD OF WATER COMMISSIONERS
416 North State Street
Jackson, Mississippi 39201

CODED

WATER WELL DRILLERS LOG

July 3 1973 — date well completed
Clark Well & Pump — firm name
Lowndes — county well located

LANDOWNER: F.A.A.
P.O. Box 2148
Highway 82 West
Columbus, Miss 39701
(mailing address)

WELL LOCATION:
sec 27 T 19 (N) (S) R 17 (E) (W)
4 miles (distance) W (direction) of Col (nearest town)

WELL PURPOSE:
(home, irrigation, municipal, industrial)

WELL COMPLETION DATA:

(1) diameter (inches) 4
(2) total depth (feet) 400
(3) static water level (feet) 110 below ~~above~~ top of ground.
(4) casing steel (material), 155 (depth), ____ (size) if telescope see back.
(5) screen ____ (length), ____ (depth to top), ____ (size), ____ (material)
(6) pump 1/2 sub (HP) 10 (yield gpm) ____ (type power)
(7) electric log ____ (yes or no) ____ (organization running log)
(8) how well bottom plugged 0

DRILLERS REMARKS:

description of formations encountered	from	to
yellow clay	0	10
grey clay	10	100
blue clay	100	120
sandy blue clay	120	150
fine sand	195	210
sandy blue clay	210	230
blue clay	230	245
fine sand	245	280
sandy blue clay	280	290
blue clay	290	315
brown clay	315	325
sandy clay	325	375
fine sand	325	380
sand	380	390
sand + rocks	390	400

AUG 13 [illegible]
MISS. BD. OF
[illegible]

If well telescopes please sketch and show depths.

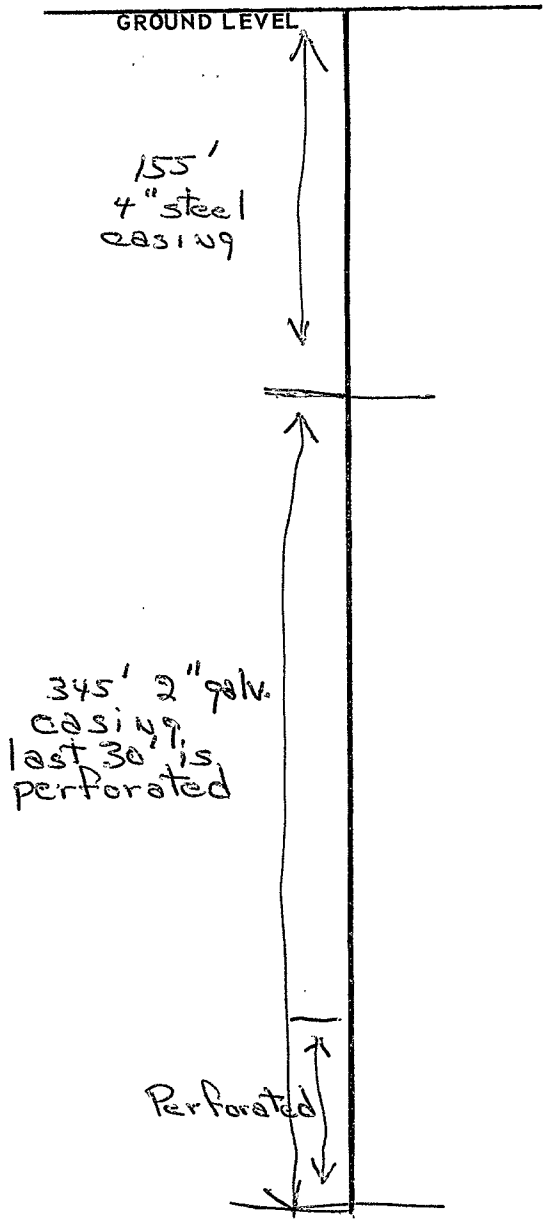

If more than one screen, show locations of each on sketch.

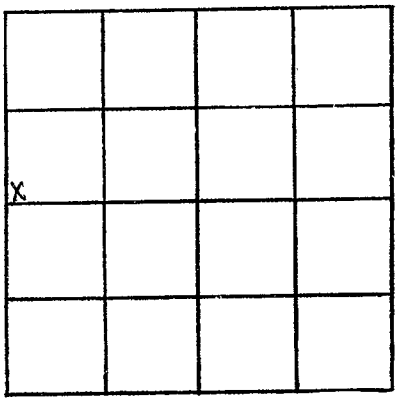

SECTION 27

Please indicate well location X.

ADDITIONAL INFORMATION