LOWNDES
F
2041

MISSISSIPPI DEPARTMENT OF NATURAL RESOURCES

Bureau of Land and Water Resources
Southport Mall
P.O. Box 10631
Jackson, Mississippi 39209

WATER WELL DRILLERS LOG

8-25-87 (date well completed) 19 Mid South Drilling Company (firm name) Lowndes (county well located)

LANDOWNER: O. C. Electric
2002 4th Ave. N
COlumbus, MS 39701
(mailing address)

WELL LOCATION:
sec. 22 T 19 (N) S R 17 (E) W
4 (distance) miles west (direction) of Columbus (nearest town)

WELL PURPOSE: home
(home, irrigation, municipal, industrial)

WELL COMPLETION DATA:

(1) diameter (inches) 4
(2) total depth (feet) 315
(3) static water level (feet) 60 (below) above top of ground.
(4) casing PVC (material), 240 (depth),
_____ (size) if telescope see back.
(5) screen 60 (length), 240 (depth to top)
2" (size), PVC (material)
(6) pump none (HP) _____ (yield gpm)
_____ (type power)
(7) electric log no (yes or no)
none (organization running log)
(8) how well bottom plugged screen

DRILLERS REMARKS:

description of formations encountered	from	to
Clay	0	60
sand w/ clay streaks	60	72
clay w/ sand streaks	72	88
clay	88	120
sand w/ clay streaks	120	133
rock	133	134
clay	147	205
clay w/ sand streaks	205	258
sand	258	270
clay w/ sand streaks	270	278
sand w/ clay streaks	278	293
sand	293	308
clay	308	315

RECEIVED
SEP 30 1987
Department of Natural Resources
Bureau of Land & Water Resources

If well telescopes please sketch and show depths.

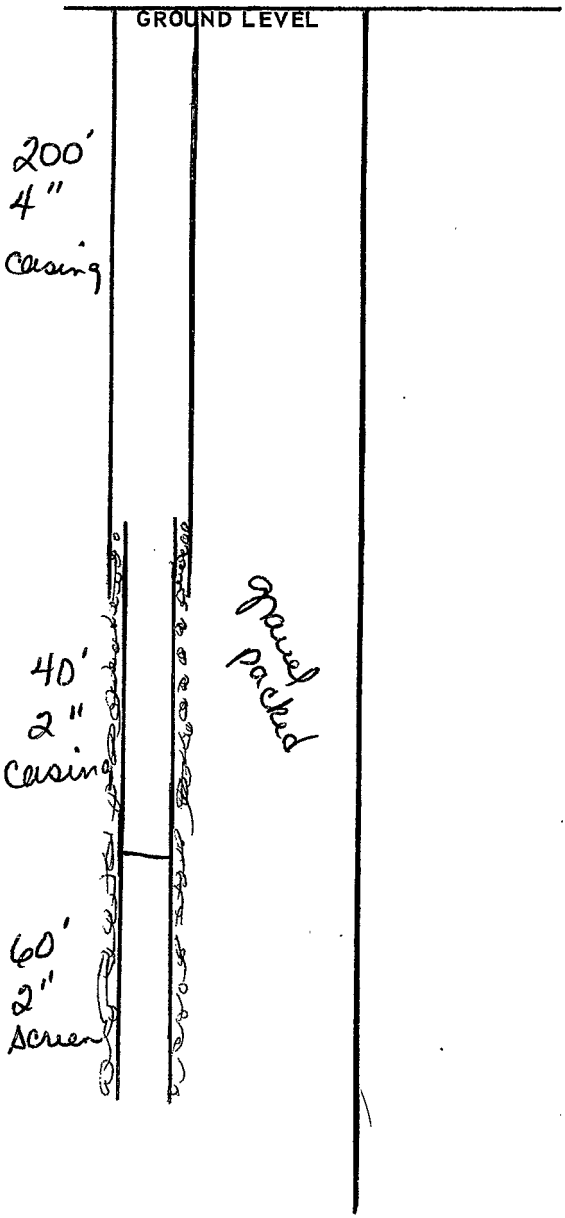

If more than one screen, show locations of each on sketch.

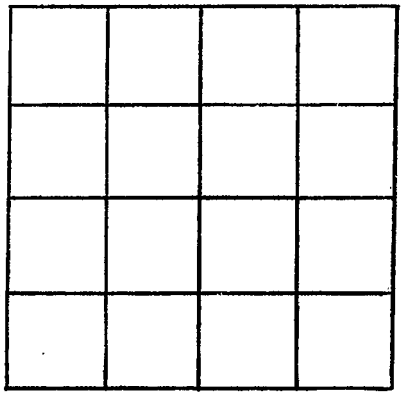

SECTION _____

Please indicate well location X.

ADDITIONAL INFORMATION