MISSISSIPPI DEPARTMENT OF NATURAL RESOURCES

Bureau of Land and Water Resources

P. O. Box 10631
Jackson, Mississippi 39209

RECEIVED
MAY 31 1990
Bureau of Land & Water Resources

WATER WELL DRILLERS LOG

COUNTY WELL LOCATED: Lowndes	
WELL NUMBER: F 2045	CODED
DATE WELL COMPLETED: 5-18-90	
PERMIT NUMBER: 0-379	
NAME OF DRILLING FIRM: Mid South Drilling, Carrollton, AL 35447	

NAME & MAILING ADDRESS OF LANDOWNER
Bill Fromm
c/o O.C. Electric
2002 4th Ave. N.
COlumbus, MS 39701
(contractor)

WELL LOCATION: SEC 17 TOWNSHIP 19N (N.) RANGE 17 (E.) W

DISTANCE 6 Miles DIRECTION West of NEAREST TOWN Columbus

OTHER LANDMARK

WELL PURPOSE: Home, Irrigation, Municipal, Industrial, Fish Pond, etc.
Home

PUMP DATA

PUMP TYPE (Circle One): Submersible, Turbine, Jet, Flowing Well, Other (Describe) ____

POWER TYPE (Circle One): Electric, Tractor, Diesel, Gasoline, Butane, Other (Describe) ____

Pump Capacity (GPM)	No. of Stages	Setting Depth
		FT.

PUMP TEST

Well yielded ____ GPM with a drawdown of ____ ft. after ____ hours of pumping

WELL DATA

Well Depth	Casing Diameter (In.)	Casing Length (Ft.)
298	4	278

Type of Casing	Hole Depth	Depth to Static Water Level
PVC	298	85

TYPE OF COMPLETION: (Circle One or More): (Gravel Packed), Underreamed, Telescoped, Natural Development, Open Hole, Other (Describe) ____

Top of Lap Pipe or Reduction in Casing
FEET — IF TELESCOPED OR MORE THAN ONE SCREEN: USE BACK PAGE

LOG DATA

TYPE OF LOG RUN (Circle One): No Log Run, Electric, Gamma Ray, Density, Sonic, Neutron, Other (Describe) ____

Name of Organization Running Log

GEOLOGIC DATA (Office Use Only)

Surface Elev.	Geologic Unit	Unit Thickness	Depth to Top
Subs. SWL	Date	Analysis	Aquifer Test

Driller's Remarks

SCREEN DATA

Diameter - Inches	Length - Feet	Slot Size - Inches
4	20	.032

Screen Type	Depth to Bottom - Feet
PVC	

DESCRIPTION OF FORMATIONS ENCOUNTERED	FROM	TO	FORMATIONS (Continued)	FROM	TO
clay	0	110	clay	193	230
sandy clay	110	149	sand	230	238
rock	149	151	clay	238	278
sandy clay	151	172	sand w/clay streak	278	298
rock	172	174			
sand	174	181			
clay	181	189			
sand	189	193			
			IF MORE SPACE IS NEEDED, USE BACK		

If well telescopes please
sketch and show depths.

GROUND LEVEL

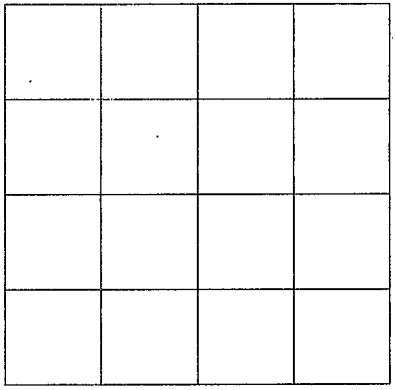

SECTION _____

Please indicate well location X.

ADDITIONAL INFORMATION

If more than one screen,
show location of each on sketch.