

Louder

6688

WATER WELL DRILLERS LOG

CODED

Date: June 6-66, 1966, Driller: W. B. Clardy County Louder
 (Name)

(1) Owner of Land: R. C. Jones
 (Name)

Masonic Sub.
 (Address)

(2) Location: Sec 2185-18W-11-18W-18S
~~SW SE~~ NE of Colo.
 (distance) (direction) (Nearest Town)

(3) Topography: flat
 (Hilly) (Flat) (Level)

(4) Purpose of Well: Domestic
 (Domestic Irrigation
 Municipal, Industrial, Other)

Description & Color of Materials Sand, Clay, Red Clay, Shell, etc.	Thick- ness Feet	Depth Feet
<u>Sand + gravel</u>	<u>7'-18'</u>	
<u>Blue Clay</u>	<u>18'</u>	
<u>Sandy streaks</u>	<u>18'-35'</u>	
<u>Blue Clay</u>	<u>35'-70'</u>	
<u>Sand</u>	<u>70'-78'</u>	
<u>Blue Clay</u>	<u>78'-125'</u>	
<u>Sand</u>	<u>125'-150'</u>	

Information upon completion of well:

(1) Diameter 4 inches.

(2) Total Depth 150 feet.

(3) Water level 5 feet below top of ground.

(4) Cased to 41', Size 4"

(5) Screen: Size _____, Length _____.


(6) Were any formations sealed against pollution?
 _____ yes, _____ no.

If YES depth of formation _____

Why _____

Drillers Remarks: _____

CODED

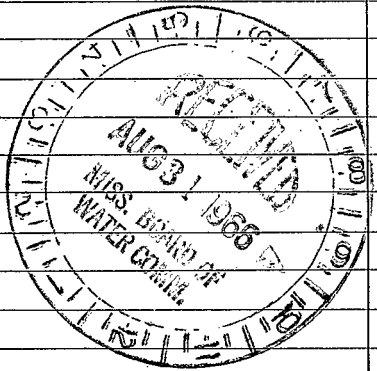

(Use Back Side)

Well No.





