

G89
3-66

WATER WELL DRILLERS LOG

CODED

Date: March, 1966, Driller: W. B. Clardy County Lounis
(Name)

(1) Owner of Land:	Description & Color of Materials Sand, Clay, Red Clay, Shell, etc.	Thick- ness -Feet	Depth -Feet
Rosie Lee David <small>(Name)</small> <u>Hwy. 82 West 3207M 5</u> <small>(Address)</small>	Sand & Gravel	10'	20'
SW $\frac{1}{4}$, NE $\frac{1}{4}$, Sec. 30 T19N R18E _____ miles _____ of _____ <small>(distance) (direction) (Nearest Town)</small>	Blue sandy clay	30'	40'
(3) Topography: _____ <small>(Hilly) (Flat) (Level)</small>	Blue rock	40'	50'
(4) Purpose of Well: <u>Domestic</u> <small>(Domestic Irrigation Municipal, Industrial, Other)</small>	3' sand		

Information upon completion of well:

(1) Diameter 4 inches.

(2) Total Depth 220 feet.

(3) Water Level 14 feet below top of ground.

(4) Cased to 42', Size 4"

(5) Screen: Size _____, Length _____


(6) Were any formations sealed against pollution?
 _____ yes, _____ no.

If YES depth of formation _____
Why _____

Drillers Remarks: _____

Description & Color of Materials Sand, Clay, Red Clay, Shell, etc.	Thick- ness -Feet	Depth -Feet
Sand & Gravel	10'	20'
Blue sandy clay	30'	40'
Blue rock	40'	50'
3' sand		
Clay - 50' - 100'		
Sand - 100' - 105'		
Clay - 105' - 160'		
Sandy streaks - 190' - 220'		

CODED

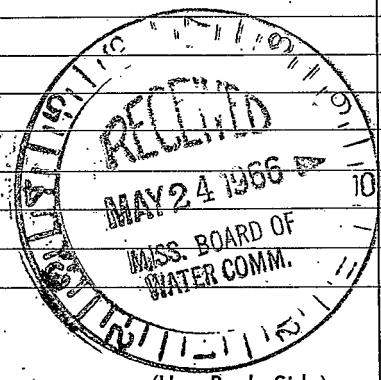

(Use Back Side)

Well No.










