

~~645~~ 645

WATER WELL DRILLERS LOG

**CODED**

9-5-60

Date: 9-5, 19 60 Driller: W. J. REEVES (County) LOWNDES

(Name)

10292 12084

(1) Owner of Land: ED PALMER  
3284537 (Name)

COLUMBUS MISS  
FOREST GLEN RD. (Address)  
SWNE

(2) Location: 1/4, 1/4, Sec. 3 TORRIS  
18 18w

2 miles N.F. of CONWAY  
(distance) (direction) (Nearest Town)

(3) Topography: HILLY  
(Hilly) (Flat) (Level)

(4) Purpose of Well: DOMESTIC  
(Domestic Irrigation  
Municipal, Industrial, Other)

Description & Color of Materials  
Sand, Clay, Red Clay, Shell, etc.

Thick-  
ness  
Feet

Depth  
Feet

RED CLAY	8	0
RED SAND	3	8
BLUE SAND	7	58
" CLAY	4	65
" SAND	3	69
RED "	20	72
BLUE CLAY	63	92
BLUE SAND	8	155
" CLAY	7	163
" SAND	5	170
" CLAY	21	175
BLUE SAND + CLAY	22	196
" "	17	218
" CLAY	27	235
" SAND + CLAY	13	262
" SAND	13	275

Information upon completion of well:

(1) Diameter 4 inches.

(2) Total Depth 288 feet.

(3) Water Level 106 feet below top of ground.

(4) Cased to 151, Size 4.

(5) Screen: Size \_\_\_\_\_, Length \_\_\_\_\_.

(6) Were any formations sealed against pollution?


\_\_\_\_\_ yes,  no.

If YES depth of formation \_\_\_\_\_

Why \_\_\_\_\_

Drillers Remarks: \_\_\_\_\_

**CODED**

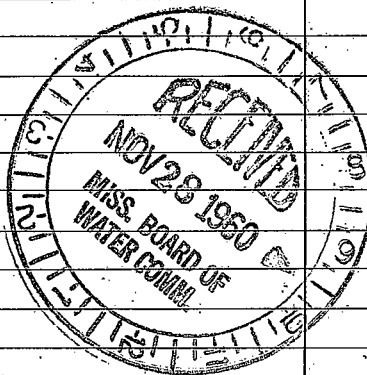

(Use Back Side)

Well No.




