Lowndes
G2112

MISSISSIPPI DEPARTMENT OF NATURAL RESOURCES

Bureau of Land and Water Resources
Southport Mall
P.O. Box 10631
Jackson, Mississippi 39209

WATER WELL DRILLERS LOG

_____ 19 _____ _____
date well completed | firm name | county well located

LANDOWNER: _____

Floyd Parker

(mailing address)

WELL LOCATION:

sec. ____ T ____ N/S R ____ E/W

____ miles ____ of ____
(distance) (direction) (nearest town)

WELL PURPOSE: _____
(home, irrigation, municipal, industrial)

WELL COMPLETION DATA:

(1) diameter (inches) _____

(2) total depth (feet) _____

(3) static water level (feet) _____ below/above top of ground.

(4) casing _____ (material), _____ (depth),

_____ (size) if telescope see back.

(5) screen _____ (length), _____ (depth to top)

_____ (size), _____ (material)

(6) pump _____ (HP) _____ (yield gpm)

_____ (type power)

(7) electric log _____ (yes or no)

_____ (organization running log)

(8) how well bottom plugged _____

DRILLERS REMARKS: _____

description of formations encountered	from	to
red clay	435	442
rock	442	
red clay	442	497
good sand	497	515
red clay	515	535
sand	535	545
red clay	545	555
rock 2"	555	
red clay	555	560
rocky	560	564
rock	560	565
rocky	565	570

RECEIVED
SEP 03 1996
Department of Natural Resources
Bureau of Land & Water Resources

If well telescopes please sketch and show depths.

GROUND LEVEL

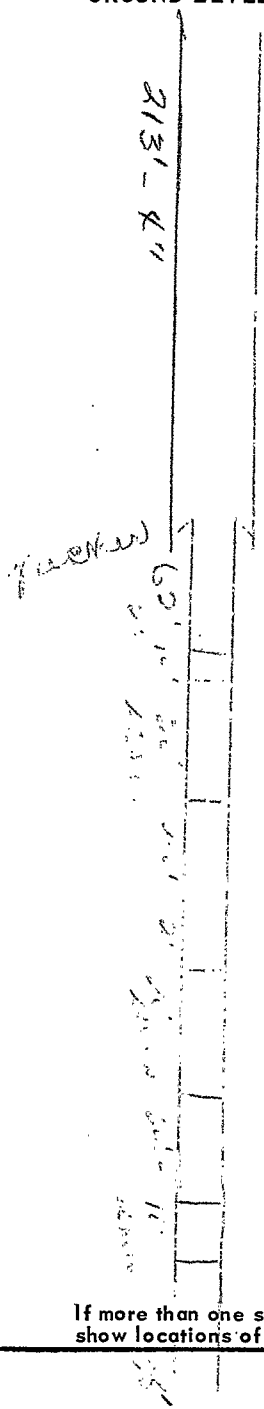

If more than one screen, show locations of each on sketch.

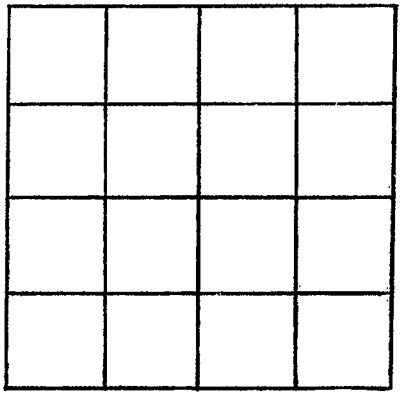

SECTION _____

Please indicate well location X.

ADDITIONAL INFORMATION