MISSISSIPPI DEPARTMENT OF ENVIRONMENTAL QUALITY
Bureau of Land and Water Resources

P. O. Box 10631
Jackson, MS 39289-0631
WATER WELL DRILLERS LOG

COUNTY WELL LOCATED: Lowndes
WELL NUMBER: G-245 CODED:
DATE WELL COMPLETED: 8/22/91

PERMIT NUMBER:
NAME OF DRILLING FIRM: Clardy Well Drilling

NAME & MAILING ADDRESS OF LANDOWNER
Charles Rector
516 Sand Rd.
Columbus, Mo.

WELL LOCATION: SEC 1 TOWNSHIP 18 (N) (S) RANGE 18 (E) (W)

DISTANCE 1 Miles DIRECTION E. of NEAREST TOWN Columbus

OTHER LANDMARK

WELL PURPOSE: Home, Irrigation, Municipal, Industrial, Fish Pond, etc.
Home

PUMP DATA

PUMP TYPE (Circle One):
(Submersible) Turbine, Jet Flowing Well,
Other (Describe)

POWER TYPE (Circle One):
(Electric,) Tractor, Diesel, Gasoline, Butane,
Other (Describe) H/P

Pump Capacity (GPM)	No. of Stages	Setting Depth
1,000 GPM	12	60 FT.

PUMP TEST
Well yielded 1,000 GPM with 3/4 hr
a drawdown of ft.
after hours of pumping

WELL DATA

Well Depth	Casing Diameter (In.)	Casing Length (Ft.)
168	4	81'

Type of Casing	Hole Depth	Depth to Static Water Level
PVC		15

TYPE OF COMPLETION: (Circle One or More):
Gravel Packed, Underreamed, Telescoped,
Natural Development, Open Hole, Other
(Describe)

Top of Lap Pipe or Reduction in Casing
FEET

IF TELESCOPED OR MORE THAN ONE SCREEN: USE BACK PAGE

LOG DATA

TYPE OF LOG RUN (Circle One): No Log Run,
Electric, Gamma Ray, Density, Sonic, Neutron,
Other (Describe)

Name of Organization Running Log

GEOLOGIC DATA (Office Use Only)

Surface Elev.	Geologic Unit	Unit Thickness	Depth to Top
Subs. SWL	Date	Analysis	Aquifer Test

Driller's Remarks

RECEIVED
SEP 09 1991
Dept. of Environmental Quality
Bureau of Land & Water Resources

SCREEN DATA

Diameter - Inches	Length - Feet	Slot Size - Inches

Screen Type	Depth to Bottom - Feet

DESCRIPTION OF FORMATIONS ENCOUNTERED	FROM	TO
Sand & Gravel	0	20
Blue Clay	20	22
Sandy Clay	22	30
Clay	30	40
Sandy Clay	40	41
Clay	41	62
Sandy Clay	62	71
Fair Clay	71	75
Sandy Clay	75	97
Rocky Sand St.	97	105
Clay	105	105½

FORMATIONS (Continued)	FROM	TO
Sandy Clay	105½	107
Clay	107	112
Sandy Clay	112	115
Clay	115	118
Rocky sand st.	118	168

IF MORE SPACE IS NEEDED, USE BACK

If well telescopes please sketch and show depths.

GROUND LEVEL

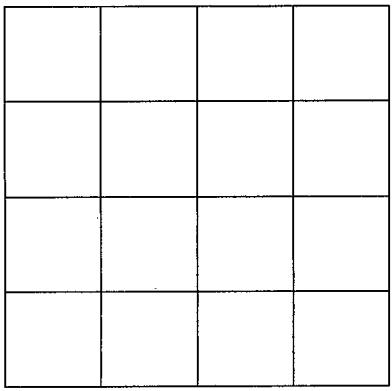

SECTION _____

Please indicate well location X.

ADDITIONAL INFORMATION

If more than one screen, show location of each on sketch.