MISSISSIPPI DEPARTMENT OF ENVIRONMENTAL QUALITY
Bureau of Land and Water Resources

P. O. Box 10631
Jackson, MS 39289-0631
WATER WELL DRILLERS LOG

COUNTY WELL LOCATED	Lowndes
WELL NUMBER	1221
CODED	
	G 2153
DATE WELL COMPLETED	12-11-91
PERMIT NUMBER	0-379
NAME OF DRILLING FIRM	Mid South Drilling
	Carrollton, AL 35447

NAME & MAILING ADDRESS OF LANDOWNER
Gene Reed
291 Coretta St.
Columbus, MS 39701

WELL LOCATION: SEC 16 TOWNSHIP 18 N (S) RANGE 18 E (W)

DISTANCE ____ Miles DIRECTION NEAREST TOWN in Columbus

OTHER LANDMARK
off hwy 82

WELL PURPOSE: Home, Irrigation, Municipal, Industrial, Fish Pond, etc.
home

PUMP DATA

PUMP TYPE (Circle One):
Submersible, Turbine, Jet Flowing Well,
Other (Describe) ____

POWER TYPE (Circle One):
Electric, Tractor, Diesel, Gasoline, Butane,
Other (Describe) ____ H/P ____

Pump Capacity (GPM)	No. of Stages	Setting Depth
		FT.

PUMP TEST
Well yielded ____ GPM with
a drawdown of ____ ft.
after ____ hours of pumping

WELL DATA

Well Depth	Casing Diameter (In.)	Casing Length (Ft.)
196	4	186

Type of Casing	Hole Depth	Depth to Static Water Level
PVC	196	55

TYPE OF COMPLETION: (Circle One or More):
Gravel Packed, Underreamed, Telescoped,
Natural Development, Open Hole, Other
(Describe) ____

Top of Lap Pipe or Reduction in Casing
FEET
IF TELESCOPED OR MORE THAN ONE SCREEN: USE BACK PAGE

LOG DATA

TYPE OF LOG RUN (Circle One): No Log Run,
Electric, Gamma Ray, Density, Sonic, Neutron,
Other (Describe) ____

Name of Organization Running Log

GEOLOGIC DATA (Office Use Only)

Surface Elev.	Geologic Unit	Unit Thickness	Depth to Top
Subs. SWL	Date	Analysis	Aquifer Test

Driller's Remarks

RECEIVED
DEC 16 1991
Dept. of Environmental Quality
Bureau of Land & Water Resources

SCREEN DATA

Diameter - Inches	Length - Feet	Slot Size - Inches
4	10	.032

Screen Type	Depth to Bottom - Feet
PVC	186

DESCRIPTION OF FORMATIONS ENCOUNTERED	FROM	TO	FORMATIONS (Continued)	FROM	TO
sand & gravel	0	20	clay	124	160
clay blue rock	20	40	sand w/clay streaks	160	170
clay w/sand streaks	40	60	clay	170	187
clay blue rock	60	80	sand	187	196
clay	80	90			
clay w/sand streaks	90	100			
sand w/clay streaks	100	120			
sand	120	124			
			IF MORE SPACE IS NEEDED, USE BACK		

If well telescopes please
sketch and show depths.

GROUND LEVEL

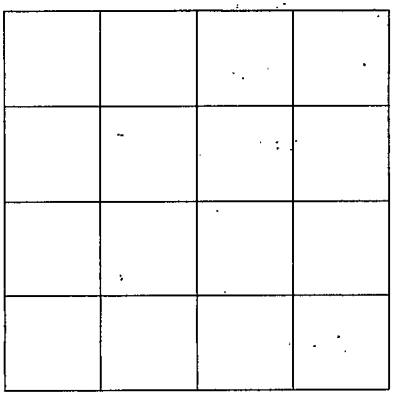

SECTION _____

Please indicate well location X.

ADDITIONAL INFORMATION

If more than one screen,
show location of each on sketch.