MISSISSIPPI DEPARTMENT OF ENVIRONMENTAL QUALITY
Bureau of Land and Water Resources

P. O. Box 10631
Jackson, MS 39289-0631
WATER WELL DRILLERS LOG

COUNTY WELL LOCATED: Lowndes	
WELL NUMBER: ~~E~~ 2156	CODED
PERMIT NUMBER	
NAME OF DRILLING FIRM: Clardy Well, Columbus, Ms	
DATE WELL COMPLETED: 3/5/92	

NAME & MAILING ADDRESS OF LANDOWNER
Ralph Williamson
P.O. Box 2268
Columbus, Ms. 39704

WELL LOCATION: SEC 7 TOWNSHIP 18 (N) (S) RANGE 18 (E) (W)

DISTANCE 1¼ Miles DIRECTION West of NEAREST TOWN Columbus

OTHER LANDMARK

WELL PURPOSE: Home, Irrigation, Municipal, Industrial, Fish Pond, etc.
Home

PUMP DATA

PUMP TYPE (Circle One): (Submersible,) Turbine, Jet Flowing Well, Other (Describe) _____

POWER TYPE (Circle One): (Electric,) Tractor, Diesel, Gasoline, Butane, Other (Describe) _____ H/P _____

Pump Capacity (GPM)	No. of Stages	Setting Depth
900 H	9	60 FT.

PUMP TEST (½ hp.)
Well yielded 900 GPM H with a drawdown of _____ ft. after _____ hours of pumping

WELL DATA

Well Depth	Casing Diameter (In.)	Casing Length (Ft.)
142'	4"	101½"
Type of Casing	**Hole Depth**	**Depth to Static Water Level**
PVC		24'

TYPE OF COMPLETION: (Circle One or More): Gravel Packed, Underreamed, Telescoped, Natural Development, Open Hole, Other (Describe) _____

Top of Lap Pipe or Reduction in Casing FEET

IF TELESCOPED OR MORE THAN ONE SCREEN: USE BACK PAGE

SCREEN DATA

Diameter - Inches	Length - Feet	Slot Size - Inches
2"	35'	.013
Screen Type		**Depth to Bottom - Feet**
PVC		

LOG DATA

TYPE OF LOG RUN (Circle One): No Log Run, Electric, Gamma Ray, Density, Sonic, Neutron, Other (Describe) _____

Name of Organization Running Log

GEOLOGIC DATA (Office Use Only)

Surface Elev.	Geologic Unit	Unit Thickness	Depth to Top
Subs. SWL	Date	Analysis	Aquifer Test

Driller's Remarks

RECEIVED
MAR 23 1992
Dept. of Environmental Quality
Bureau of Land & Water Resources

DESCRIPTION OF FORMATIONS ENCOUNTERED	FROM	TO	FORMATIONS (Continued)	FROM	TO
Red Clay	0	7			
Sand & gravel	7	40			
Sandy Clay	40	55			
Clay	55	72			
Sandy clay	72	84			
Clay	84	92			
Sandy clay	92	105			
Sand	105	142			
			IF MORE SPACE IS NEEDED, USE BACK		

If well telescopes please
sketch and show depths.

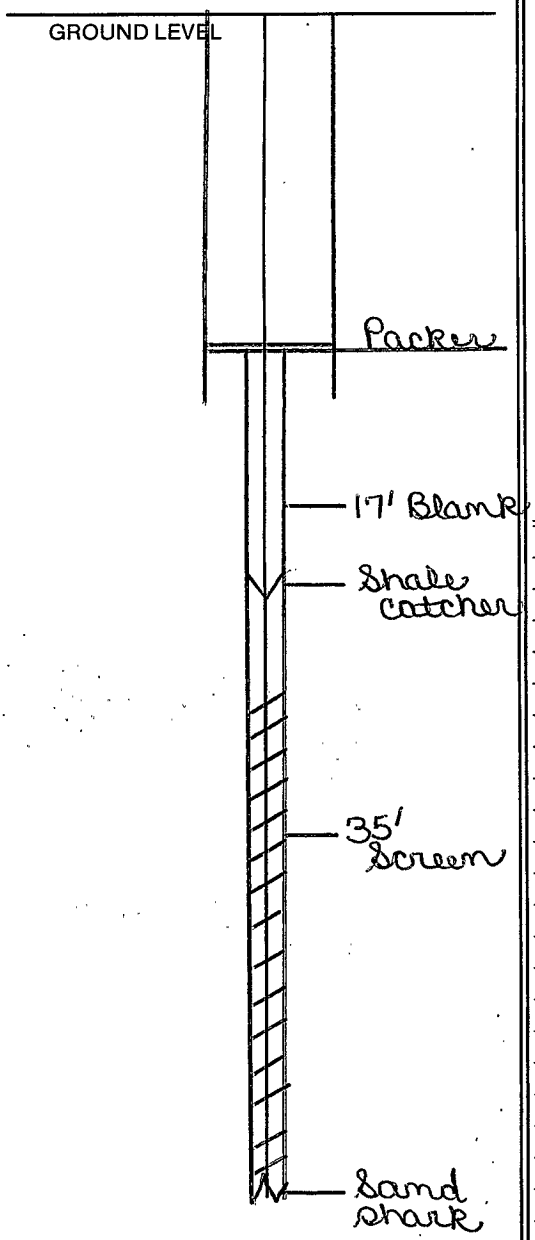

If more than one screen,
show location of each on sketch.

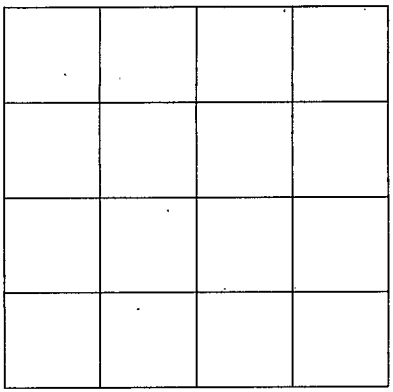

SECTION _____

Please indicate well location X.

ADDITIONAL INFORMATION