

H

Y 308

11-11-60

WATER WELL DRILLERS LOG

Date: 11-11, 1960, Driller: W. J. REEVES & SON County LOWNDES

(Name)

(1) Owner of Land: ED WITKE
(Name)

COLUMBUS, MISS
(Address)

(2) Location: 1/4, 1/4, Sec. 11 T18R12W

1 miles E, of COLUMBUS,
(distance) (direction) (Nearest Town)

(3) Topography: FLAT
(Hilly) (Flat) (Level)

(4) Purpose of Well: DOMESTIC
(Domestic Irrigation
Municipal, Industrial, Other)

Description & Color of Materials
Sand, Clay, Red Clay, Shell, etc.

Thick-
ness
Feet

Depth
Feet

CLAY	7	0
SAND & GRAVEL	17	7
BLUE CLAY	37	26
BLUE SAND	29	61

Information upon completion of well:

(1) Diameter 4 inches.

(2) Total Depth 90 feet.

(3) Water Level 8 feet below top of ground.

(4) Cased to 27', Size 4"

(5) Screen: Size _____, Length _____


(6) Were any formations sealed against pollution?

_____ yes, _____ no.

If YES depth of formation _____

Why _____

Drillers Remarks: _____

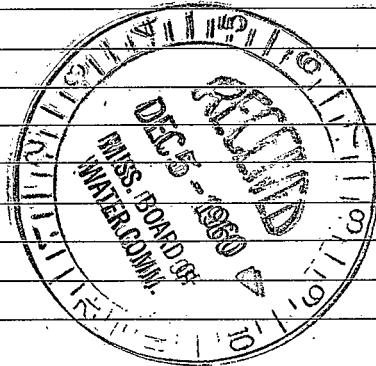

(Use Back Side)

Well No.





