

BH 2001
8-14-61

WATER WELL DRILLERS LOG

Date: 8-14, 1961, Driller: J.C. REEVES County LOWNDES
11362 (Name)

(1) Owner of Land: H.C. BARKSDALE
(Name)
Columbus, Miss
(Address)

(2) Location: 1/4, 1/4, Sec. 20 T16R17,
S W
_____ miles _____ of Columbus,
(distance) (direction) (Nearest Town)

(3) Topography: FLAT
(Hilly) (Flat) (Level)

(4) Purpose of Well: DOM.
(Domestic Irrigation
Municipal, Industrial, Other)

Description & Color of Materials Sand, Clay, Red Clay, Shell, etc.	Thick- ness Feet	Depth Feet
CLAY	8	0
SAND & GRAVEL	10	8
BLUE CLAY	7	18
" SAND	14	25
" CLAY	36	39
" SAND	12	75
" CLAY	4	87
" SAND	20	91

Information upon completion of well:

(1) Diameter 4 inches.

(2) Total Depth 111 feet.

(3) Water Level 17 feet below top of ground.

(4) Cased to 21', Size 4"


(5) Screen: Size _____, Length _____.

(6) Were any formations sealed against pollution?
_____ yes, _____ no.

If YES depth of formation _____

Why _____

Drillers Remarks: _____

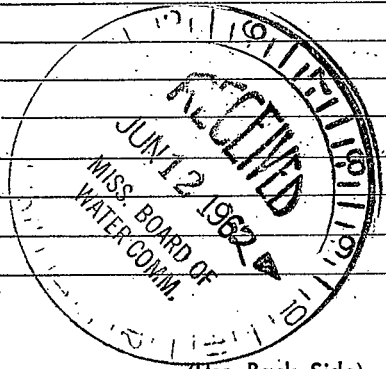

(Use Back Side)

Well No.





