Lowndes
H 2029

MISSISSIPPI
BOARD OF WATER COMMISSIONERS
416 North State Street
Jackson, Mississippi 39201

WATER WELL DRILLERS LOG

March 4 1982 Mid-South Drilling Lowndes
date well completed | firm name | county well located

LANDOWNER: George Derden
Beersheba Road

Columbus, MS 39701
(mailing address)

WELL LOCATION:
sec. 23 T 18 S R 17 E

2 (distance) miles N (direction) of New Hope (nearest town)

WELL PURPOSE: home
(home, irrigation, municipal, industrial)

WELL COMPLETION DATA:

(1) diameter (inches) 4

(2) total depth (feet) 255

(3) static water level (feet) 105 below ~~above~~ top of ground.

(4) casing PVC (material), 165 (depth),
4" (size) if telescope see back.

(5) screen n/a (length), (depth to top)
(size), (material)

(6) pump 1/2 (HP) 8 (yield gpm)
(type power)

(7) electric log no (yes or no)
no (organization running log)

(8) how well bottom plugged open

DRILLERS REMARKS:

description of formations encountered	from	to
clay	0	17
sand & gravel	17	29
clay & ~~XXXXX~~ sand	29	60
clay	60	90
clay & sand	90	180
clay & sand	180	255

DEPT. OF NATURAL RESOURCES
BUREAU OF LAND & WATER RESOURCES
MAR 29 1982
RECEIVED

If well telescopes please sketch and show depths.

GROUND LEVEL

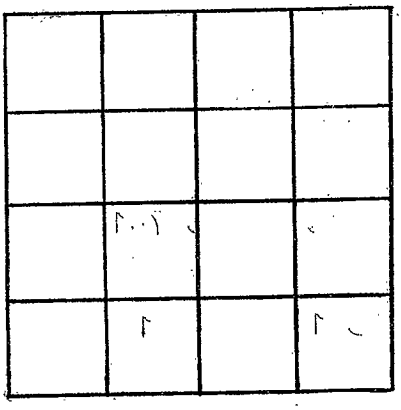

SECTION _____

Please indicate well location X.

ADDITIONAL INFORMATION

If more than one screen, show locations of each on sketch.