Lowndes
H
2051

MISSISSIPPI DEPARTMENT OF NATURAL RESOURCES

Bureau of Land and Water Resources
Southport Mall
P.O. Box 10631
Jackson, Mississippi 39209

WATER WELL DRILLERS LOG

10-25-84, 19 — Clardy Well Drilling — Lowndes
date well completed — firm name — county well located

LANDOWNER:
Fred Williamson
Hwy 82 S
Columbus, MS
(mailing address)

WELL LOCATION:
sec. 20 T 18 N/S R 17 E/W
1/2 miles E of Cols.
(distance) (direction) (nearest town)

WELL PURPOSE: Home
(home, irrigation, municipal, industrial)

WELL COMPLETION DATA:

(1) diameter (inches) 4"
(2) total depth (feet) 230
(3) static water level (feet) 28' below ~~above~~ top of ground.
(4) casing PVC (material), 114' (depth), 4" (size) if telescope see back.
(5) screen 30' (length), _____ (depth to top), 2" (size), PVC (material)
(6) pump 1 (HP) 1200 gpm (yield gpm)
elec (type power)
(7) electric log no (yes or no)
_____ (organization running log)
(8) how well bottom plugged _____

DRILLERS REMARKS: _____

description of formations encountered	from	to
red Clay	0	13
sand & gravel	13	20
blue Clay	20	31
sandy Clay	31	58
rock	58	60
sandy Clay	60	66
good Clay	66	114
rock	114	114½
good Clay	114½	133
sandy Clay	133	146
hard brown Clay	146	198
sand	198	215½
rock	215½	216
sand	216	225
brown Clay	225	230

DEPT. OF NATURAL RESOURCES
BUREAU OF LAND & WATER RESOURCES
NOV 29 1984
RECEIVED

If well telescopes please sketch and show depths.

GROUND LEVEL

114' - 4"

96' - 3"

Bottom

If more than one screen, show locations of each on sketch.

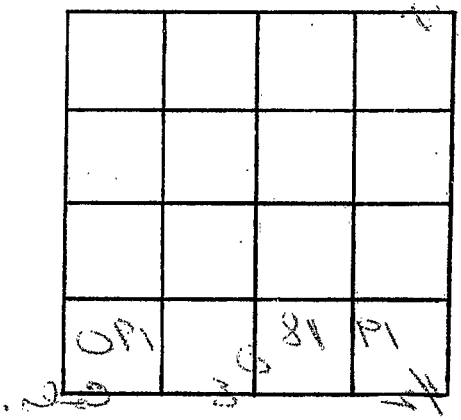

SECTION _____

Please indicate well location X.

ADDITIONAL INFORMATION