LOWNDES

7/29/80

MISSISSIPPI
BOARD OF WATER COMMISSIONERS
416 North State Street
Jackson, Mississippi 39201

WATER WELL DRILLERS LOG

7-29-80 — Martin & Kelly — Lowndes

date well completed — firm name — county well located

LANDOWNER: E. R. Bishop
Rt 2 - Box 43
Caledonia Ms. 39740
(mailing address)

WELL LOCATION:
sec. ___ T ___ N S R ___ E W
1½ miles East of Kelly
(distance) (direction) (nearest town)

WELL PURPOSE: Home
(home, irrigation, municipal, industrial)

WELL COMPLETION DATA:

(1) diameter (inches) 5"
(2) total depth (feet) 220
(3) static water level (feet) 28' below ~~above~~ top of ground.
(4) casing P.V.C. (material), 67' (depth), 5 (size) if telescope see back.
(5) screen ___ (length), ___ (depth to top), ___ (size), ___ (material)
(6) pump ½ (HP) 18 (yield gpm) E (type power)
(7) electric log ___ (yes or no)
___ (organization running log)
(8) how well bottom plugged open

DRILLERS REMARKS: ___

description of formations encountered	from	to
Clay	0	14
Gravel	14	37
Blue Clay	37	70
Sand & Clay Streaks	70	220

DEPT. OF NATURAL RESOURCES
BUREAU OF LAND & WATER RESOURCES
AUG 11 1980
RECEIVED

If well telescopes please sketch and show depths.

GROUND LEVEL

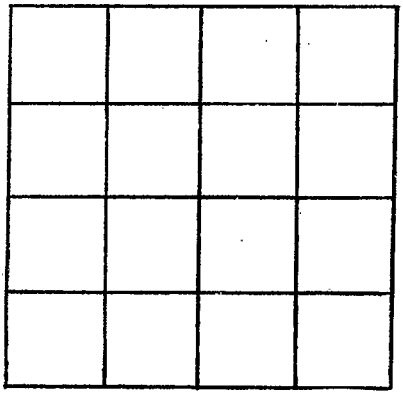

SECTION _____

Please indicate well location X.

ADDITIONAL INFORMATION

If more than one screen, show locations of each on sketch.