LOWNDES
K30
5-10-76

MISSISSIPPI
BOARD OF WATER COMMISSIONERS
416 North State Street
Jackson, Mississippi 39201

WATER WELL DRILLERS LOG

CODED

5-10 date well completed 1976 W J REEDES & SON firm name LOWNDES county well located

LANDOWNER: MACK HOWARD
RT. 1
COLUMBUS
(mailing address)

WELL LOCATION:
sec. 2 T 18 N (S) R 17 E (W)
6 (distance) miles SW (direction) of COLUMBUS (nearest town)

WELL PURPOSE: HOME
(home, irrigation, municipal, industrial)

WELL COMPLETION DATA:
(1) diameter (inches) 4
(2) total depth (feet) 340
(3) static water level (feet) 45 below ~~above~~ top of ground.
(4) casing PVC (material), 300 (depth), 4 (size) If telescope see back.
(5) screen 40 (length), 300 (depth to top), 4 (size), PVC (material)
(6) pump 5 (HP) 50 (yield gpm) ELECT (type power)
(7) electric log No (yes or no)
(organization running log)
(8) how well bottom plugged SAND

DRILLERS REMARKS:

description of formations encountered	from	to
CLAY	0	14
BLUE "	14	70
" SAND	70	77
HARD ROCK	77	78
BLUE SAND	78	150
" CLAY	150	160
" SAND + CLAY	160	225
" "	225	235
" CLAY	235	250
" " + SAND	250	270
" SAND	270	305
" CLAY	305	310
" SAND	310	325
" " + CLAY	325	340

RECEIVED
MISS. BD. OF WATER COM.

If well telescopes please sketch and show depths.

GROUND LEVEL

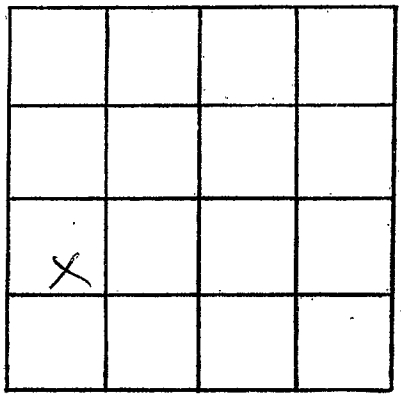

SECTION 3

Please indicate well location X.

ADDITIONAL INFORMATION

If more than one screen, show locations of each on sketch.