MISSISSIPPI DEPARTMENT OF NATURAL RESOURCES

Bureau of Land and Water Resources

P.O. Box 10631
Jackson, Mississippi 39209

WATER WELL DRILLERS LOG

COUNTY WELL LOCATED: Lowndes
WELL NUMBER: K 2013 | CODED:
DATE WELL COMPLETED: 4/24/97

PERMIT NUMBER:
NAME OF DRILLING FIRM: Cleardy Well Columbus, MS

NAME & MAILING ADDRESS OF LANDOWNER
Larry Collums
654 Valley Rd.
Columbus, MS 39701

WELL LOCATION: SEC 12 TOWNSHIP 18 N (S) RANGE 19 (E) W

DISTANCE: 4 Miles DIRECTION: W of NEAREST TOWN: Col.

OTHER LANDMARK:

WELL PURPOSE: Home, Irrigation, Municipal, Industrial, Fish Pond, etc.
Home

PUMP DATA

PUMP TYPE (Circle One): (Submersible), Turbine, Jet, Flowing Well, Other (Describe)

POWER TYPE (Circle One): (Electric), Tractor, Diesel, Gasoline, 3/4 Butane, Other (Describe) H/P

Pump Capacity (GPM)	No. of Stages	Setting Depth
900 H	12	140 FT.

PUMP TEST

Well yielded _____ GPM with a drawdown of _____ ft. after _____ hours of pumping

WELL DATA

Well Depth	Casing Diameter (In.)	Casing Length (Ft.)
242	4"	153'

Type of Casing	Hole Depth	Depth to Static Water Level
PVC		60'

TYPE OF COMPLETION: (Circle One or More): Gravel Packed, Underreamed, Telescoped, Natural Development, Open Hole, Other (Describe)

Top of Lap Pipe or Reduction in Casing FEET

IF TELESCOPED OR MORE THAN ONE SCREEN: USE BACK PAGE

SCREEN DATA

Diameter - Inches	Length - Feet	Slot Size - Inches
2"	40'	.016

Screen Type	Depth to Bottom - Feet
PVC	

LOG DATA

TYPE OF LOG RUN (Circle One): No Log Run, Electric, Gamma Ray, Density, Sonic, Neutron, Other (Describe)

Name of Organization Running Log

RECEIVED
MAY 08 1997
Dept. of Environmental Quality
Office of Land & Water Resources

GEOLOGIC DATA (Office Use Only)

Surface Elev.	Geologic Unit	Unit Thickness	Depth to Top
Subs. SWL	Date	Analysis	Aquifer Test

Driller's Remarks

DESCRIPTION OF FORMATIONS ENCOUNTERED	FROM	TO
Brown clay	0	8
Sandy blue clay	8	66
Sandy clay	66	116
Rock	116	117½
Sandy clay	117½	124
Rock	124	125
Sandy clay	125	141
Fair clay	141	164
Fine sand	164	174
Clay	174	185
Sandy clay	185	199

FORMATIONS (Continued)	FROM	TO
Sand	199	242

IF MORE SPACE IS NEEDED, USE BACK

If well telescopes please sketch and show depths.

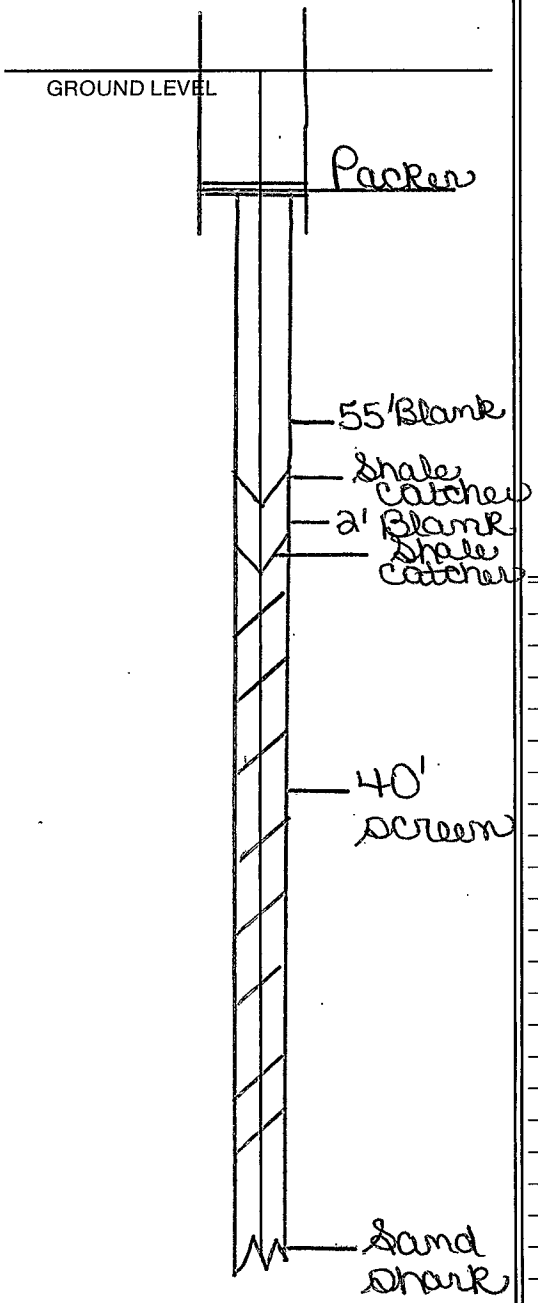

If more than one screen, show location of each on sketch.

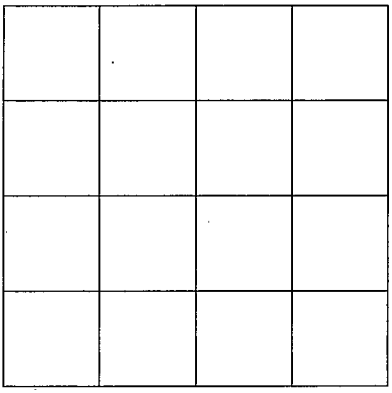

SECTION _____

Please indicate well location X.

ADDITIONAL INFORMATION