Lowndes

? L

1-16-81

MISSISSIPPI DEPARTMENT OF NATURAL RESOURCES
Bureau of Land and Water Resources
Southport Mall
P.O. Box 10631
Jackson, Mississippi 39209

WATER WELL DRILLERS LOG

1981 Clardy Well Drilling Lowndes

date well completed — firm name — county well located

LANDOWNER: J.W. Hanson
Hwy 182 So
Columbus Miss.
(mailing address)

WELL LOCATION:
sec. 3 T 18 N (S) R 19 (E) W
? 12 miles So of Colu.
(distance) (direction) (nearest town)

WELL PURPOSE: industrial
(home, irrigation, municipal, industrial)

WELL COMPLETION DATA:

(1) diameter (inches) 4"

(2) total depth (feet) 135

(3) static water level (feet) 1' below above top of ground.

(4) casing PVC (material), 66' (depth),
(size) if telescope see back.

(5) screen (length), (depth to top)
(size), (material)

(6) pump 1/2 (HP) 800 gph (yield gpm)
(type power)

(7) electric log (yes or no)
(organization running log)

(8) how well bottom plugged open

DRILLERS REMARKS:

description of formations encountered	from	to
Clay	24	96
sand	96	97
Clay	97	104
sand	104	105
Clay	105	106
sand	106	108
Clay	108	114
sand	114	119
Clay	119	120
sand	120	135

If well telescopes please sketch and show depths.

GROUND LEVEL

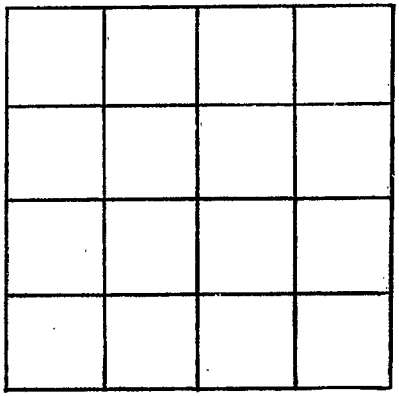

SECTION _____

Please indicate well location X.

ADDITIONAL INFORMATION

If more than one screen, show locations of each on sketch.