

MISSISSIPPI DEPARTMENT OF NATURAL RESOURCES


Bureau of Land and Water Resources

Southport Mall

P.O. Box 1063
Jackson, Mississippi 39209

WATER WELL DRILLERS LOG

LOWNDES
M 2050

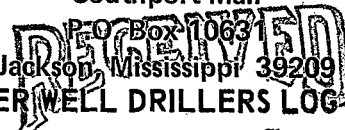


April 6 19 87 Mid South Drilling Co. Lowndes
 date well completed firm name county well located

	Department of Natural Resources Bureau of Land & Water Resources		
LANDOWNER: Roy Guyton	description of formations encountered	from	to
Rt. 6 Box 120	sand	0	8
Columbus, MS 39701	clay	8	35
(mailing address)	clay w/sand streaks	35	135
WELL LOCATION:	clay	135	178
sec 22XX T 19XX S R 1S ^{17W} E XX	sand	178	183
5 miles SE of New Hope	clay	183	194
(distance) (direction) (nearest town)	sand	194	206
WELL PURPOSE:	clay	206	232
(home, irrigation, municipal, industrial)	sand	232	242
WELL COMPLETION DATA:	clay	242	249
(1) diameter (inches) 4"	sand	249	262
(2) total depth (feet) 287'	clay	262	266
(3) static water level (feet) 102' below top of ground. 102XX	sand	266	270
(4) casing PVC (material), 160' (depth), 4 (size) if telescope see back.	clay w/sand streaks	270	280
(5) screen none (length), (depth to top) (size) (material)	sand	280	287
(6) pump none (HP) (yield gpm) (type power)	rock at 147, 153, 170, 175		
(7) electric log no (yes or no) no (organization running log)	183, 235, 237, 239		
(8) how well bottom plugged open			

DRILLERS REMARKS:

If well telescopes please
sketch and show depths.

GROUND LEVEL

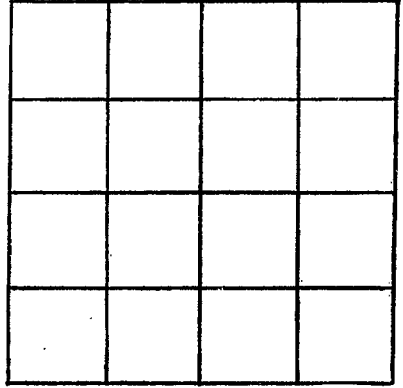

SECTION _____

Please indicate well location X.

ADDITIONAL INFORMATION

If more than one screen,
show locations of each on sketch.