LOWNDES
N 2004
4-15-76

13L

MISSISSIPPI
BOARD OF WATER COMMISSIONERS
416 North State Street
Jackson, Mississippi 39201

WATER WELL DRILLERS LOG

4-15 1976 Anthony Drilling Co. Lowndes
date well completed firm name county well located
Anthony

LANDOWNER: Doug Buccahanan
Crawford, Miss.
(mailing address)

WELL LOCATION:
sec. 26 T 17 N R 16 E
2 miles E of Crawford
(distance) (direction) (nearest town)

WELL PURPOSE: Home
(home, irrigation, municipal, industrial)

WELL COMPLETION DATA:

(1) diameter (inches) 4"
(2) total depth (feet) 760
(3) static water level (feet) 80 below/above top of ground.
(4) casing PVC (material), 20' top (depth)
— (size) if telescope see back.
(5) screen 105 (length), 740 (depth to top)
2" (size), PVC (material)
(6) pump 3/4 (HP) 12 (yield gpm)
elect (type power)
(7) electric log no (yes or no)
(organization running log)
(8) how well bottom plugged
Backwash valve

DRILLERS REMARKS:

description of formations encountered	from	to
Clay	0	10
Limestone	10	520
Sand & Shale	520	760

JUN 9 1976
MISS. BD. OF WATER COMMS.

If well telescopes please sketch and show depths.

GROUND LEVEL

20' 4"
top casing

Limestone

260' 2"
PVC
Casing
+
Screen

If more than one screen, show locations of each on sketch.

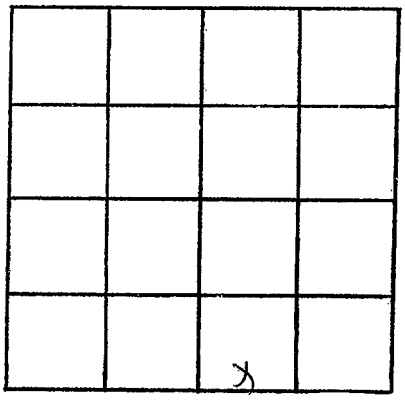

SECTION 26

Please indicate well location X.

ADDITIONAL INFORMATION