Lowndes
N2029

MISSISSIPPI
BOARD OF WATER COMMISSIONERS
416 North State Street
Jackson, Mississippi 39201

WATER WELL DRILLERS LOG

August 24 (date well completed) 19 84 Mid South Drilling Company (firm name) Lowndes (county well located)

LANDOWNER: Fraizer, John T.

921 Main Street

Columbus, MS 39701
(mailing address)

WELL LOCATION:
sec. 16 T 17 (N/S) R 16 (E/W)

1 (distance) miles north (direction) of Crawford (nearest town)

WELL PURPOSE: home
(home, irrigation, municipal, industrial)

WELL COMPLETION DATA:

(1) diameter (inches) 4"

(2) total depth (feet) 780'

(3) static water level (feet) 120' below ~~above~~ top of ground.

(4) casing PVC (material), 415 (depth),
back (size) if telescope see back.

(5) screen 140 (length), 415 (depth to top)
2" (size), .032 PVC (material)

(6) pump 3/4 (HP) 10 (yield gpm)
Kelectric (type power)

(7) electric log no (yes or no)
none (organization running log)

(8) how well bottom plugged screen

DRILLERS REMARKS:

description of formations encountered	from	to
clay	0	555
clay and sand	555	770
clay	770	780

DEPT. OF NATURAL RESOURCES
BUREAU OF LAND & WATER RESOURCES
OCT 1 1984
RECEIVED

If well telescopes please sketch and show depths.

GROUND LEVEL

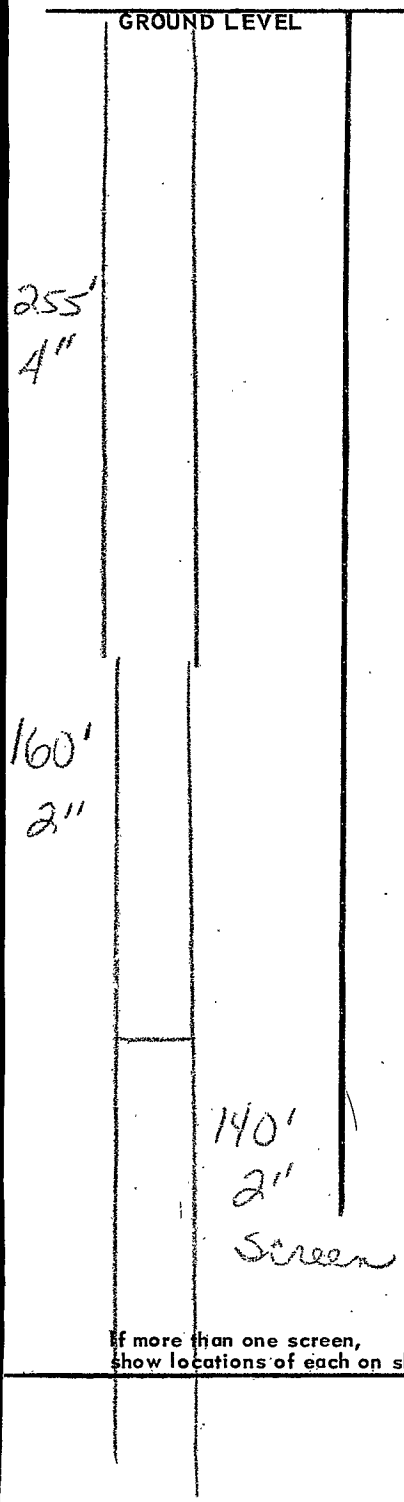

If more than one screen, show locations of each on sketch.

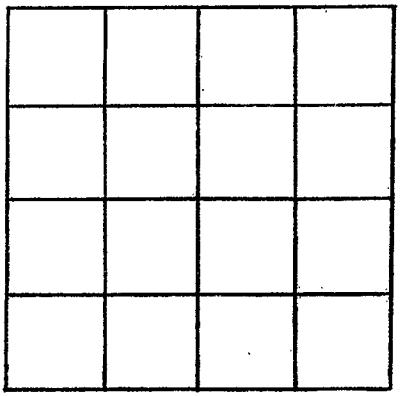

SECTION _____

Please indicate well location X.

ADDITIONAL INFORMATION