LOWNDES
P17
3-10-73

MISSISSIPPI
BOARD OF WATER COMMISSIONERS
416 North State Street
Jackson, Mississippi 39201

CODED

WATER WELL DRILLERS LOG

3-10 (date well completed) 1973 Anthony Drilling Co. (firm name) Lowndes (county well located)

LANDOWNER: Jay Shertz
Lowndes, Ill. (mailing address)

WELL LOCATION:
sec 17 T 17 (N/S) R 18 (E/W)
15 (distance) miles South (direction) of Col. (nearest town)

WELL PURPOSE: Home (home, irrigation, municipal, industrial)

WELL COMPLETION DATA:

(1) diameter (inches) 4"
(2) total depth (feet) 400'
(3) static water level (feet) 80' below top of ground.
(4) casing P.V.C. (material), 21' Top (depth), ____ (size) if telescope see back.
(5) screen 84' (length), ____ (depth to top) 2" (size), P.V.C (material)
(6) pump 1 (HP) 15 (yield gpm) elect. (type power)
(7) electric log no (yes or no) ____ (organization running log)
(8) how well bottom plugged capped

DRILLERS REMARKS:

description of formations encountered	from	to
Clay	0	10'
Limestone	10'	135'
Sand + Shale	135	400

CODED

MAR 15 1973

If well telescopes please sketch and show depths.

GROUND LEVEL

21'
4" P.V.C.
Casing

Limestone

Sand
&
Shale
84'
Screen

If more than one screen, show locations of each on sketch.

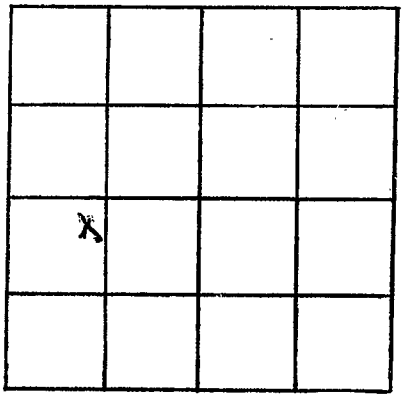

SECTION 17

Please indicate well location X.

ADDITIONAL INFORMATION