LOWNDES

Q 7000

3/17/75

MISSISSIPPI
BOARD OF WATER COMMISSIONERS
416 North State Street
Jackson, Mississippi 39201

WATER WELL DRILLERS LOG

March 17 (date well completed) 19 75 Allsup Drilling Inc. (firm name) Lowndes (county well located)

LANDOWNER: Mr. James J. Hairston - Mr. Robert E. Smith
Rt. 1 Box 67
Crawford Ms. 39743
(mailing address)

WELL LOCATION:
sec 30 T 17 N R 17 E 19 E
4 1/2 (distance) miles W E (direction) of Crawford (nearest town)

WELL PURPOSE: home
(home, irrigation, municipal, industrial)

WELL COMPLETION DATA:
(1) diameter (inches) 4" X 2"
(2) total depth (feet) 700'
(3) static water level (feet) 65 below above top of ground.
(4) casing 4" Plastic (material), 27' (depth),
4" X 2" (size) if telescope see back.
(5) screen 80' (length), 620' (depth to top)
4" X 2" (size), Plastic (material)
(6) pump 1/2 (HP), 11 (yield gpm)
Electric (type power)
(7) electric log NO (yes or no)
(organization running log)
(8) how well bottom plugged CAP

DRILLERS REMARKS:

description of formations encountered	from	to
Clay	0	17
Lime Rock	17	500
SAND	500	550
Muck	550	570
SAND	570	700

RECEIVED
APR 18 1975
MISS. BD. OF WATER COMM.

If well telescopes please sketch and show depths.

GROUND LEVEL

97'
4 "

380'
2 "

40' Screen

If more than one screen, show locations of each on sketch.

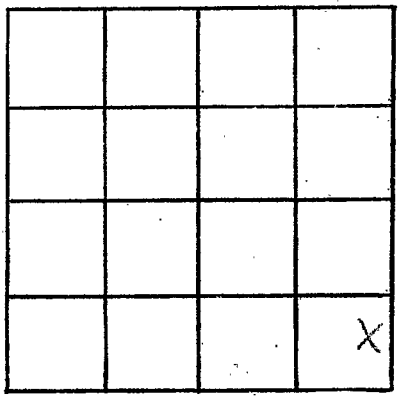

SECTION 30

Please indicate well location X.

ADDITIONAL INFORMATION