MISSISSIPPI DEPARTMENT OF NATURAL RESOURCES

Bureau of Land and Water Resources

P.O. Box 10631
Jackson, Mississippi 39209

WATER WELL DRILLERS LOG

COUNTY WELL LOCATED: Lowndes	PERMIT NUMBER
WELL NUMBER: Q 7092 / CODED	NAME OF DRILLING FIRM: Clardy Well Drill.
DATE WELL COMPLETED: 2/16/87	501 Warpath Road

NAME & MAILING ADDRESS OF LANDOWNER
Richard Byrant
P. O. Box 2035
Columbus, Ms. 39701

WELL LOCATION: SEC 18 TOWNSHIP 20 N (S) RANGE 17 (E) (W)

DISTANCE 8½ Miles DIRECTION South of NEAREST TOWN Columbus

OTHER LANDMARK

WELL PURPOSE: Home, Irrigation, Municipal, Industrial, Fish Pond, etc.
Home

PUMP DATA

PUMP TYPE (Circle One): (Submersible), Turbine, Jet, Flowing Well, Other (Describe)

POWER TYPE (Circle One): (Electric), Tractor, Diesel, Gasoline, Butane, Other (Describe)

Pump Capacity (GPM)	No. of Stages	Setting Depth
900		80 FT.

PUMP TEST

Well yielded 900 GPM with a drawdown of _____ ft. after _____ hours of pumping

WELL DATA

Well Depth	Casing Diameter (In.)	Casing Length (Ft.)
137	4	85

Type of Casing	Hole Depth	Depth to Static Water Level
PVC		8'

TYPE OF COMPLETION: (Circle One or More): Gravel Packed, Underreamed, Telescoped, Natural Development, (Open Hole), Other (Describe)

Top of Lap Pipe or Reduction in Casing: FEET

IF TELESCOPED OR MORE THAN ONE SCREEN: USE BACK PAGE

LOG DATA

TYPE OF LOG RUN (Circle One): (No Log Run), Electric, Gamma Ray, Density, Sonic, Neutron, Other (Describe)

Name of Organization Running Log

GEOLOGIC DATA (Office Use Only)

Surface Elev.	Geologic Unit	Unit Thickness	Depth to Top
Subsurface Data	Date	Analysis	Aquifer Test

Driller's Remarks

RECEIVED
MAR 16 1987
Department of Natural Resources
Bureau of Land & Water Resources

SCREEN DATA

Diameter - Inches	Length - Feet	Slot Size - Inches

Screen Type	Depth to Bottom - Feet

DESCRIPTION OF FORMATIONS ENCOUNTERED	FROM	TO	FORMATIONS (Continued)	FROM	TO
Sand & gravel	0	22	Clay	102	106½
Clay	22	46	Sand streak	106½	136
Fine sand streak	46	55	Clay	136	137
Good clay	55	64			
Fine sandy clay	64	67½			
Clay	67½	68½			
Sand streak	68½	74			
Good clay	74	83			
Sandy clay	83	102			
			IF MORE SPACE IS NEEDED, USE BACK		

If well telescopes please
sketch and show depths.

GROUND LEVEL

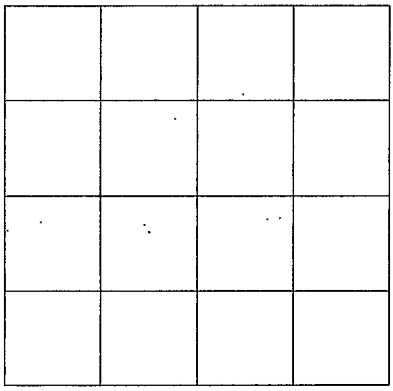

SECTION _____

Please indicate well location X.

ADDITIONAL INFORMATION

If more than one screen,
show location of each on sketch.