

OF 24
2-5-65

WATER WELL DRILLERS LOG **CODED**

Date: 2/5, 1965, Driller: McKay County Madison
(Name)

(1) Owner of Land: See BANK'S
(Name)
Canton Miss
(Address)

(2) Location: 1/4, 1/4, Sec. 13 T10 R2E
2 miles S of WAY
(distance) (direction) (Nearest Town)

(3) Topography: (Hilly) (Flat) (Level)

(4) Purpose of Well: Home
(Domestic Irrigation
Municipal, Industrial, Other)

Description & Color of Materials Sand, Clay, Red Clay, Shell, etc.	Thick- ness Feet	Depth Feet
<u>Red clay</u>	<u>0</u>	<u>2.0</u>
<u>Red Sand</u>	<u>20</u>	<u>4.0</u>
<u>Blue clay</u>	<u>40</u>	<u>6.0</u>
<u>Blue clay</u>	<u>60</u>	<u>8.0</u>
<u>Blue clay</u>	<u>80</u>	<u>14.0</u>
<u>Sandy Shale</u>	<u>140</u>	<u>16.0</u>
<u>Sand</u>	<u>160</u>	<u>18.0</u>
<u>Sand</u>	<u>180</u>	<u>30.0</u>

Information upon completion of well:

(1) Diameter 2 inches.

(2) Total Depth 300 feet.

(3) Water Level 30 feet below top of ground.

(4) Cased to _____, Size _____.

(5) Screen: Size 007, Length 10.


(6) Were any formations sealed against pollution?
_____ yes, no.

If YES depth of formation _____
Why _____

Drillers Remarks: _____

CODED

1/2 H.P. Jet Pump

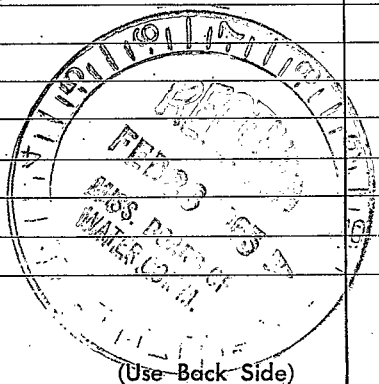

Well No.








