

F27

12-2-65

WATER WELL DRILLERS LOG

CODED


Date: 12/2, 1965, Driller: Forest Drilling County Madison
 (Name)

(1) Owner of Land:	Description & Color of Materials Sand, Clay, Red Clay, Shell, etc.	Thick- ness Feet	Depth Feet
<u>Charles Hargan</u> (Name)	<u>Brown Silt</u>		<u>18</u>
<u>Rt 3 box 183 Canton</u> (Address)	<u>Wh. sand + Clay</u>		<u>24</u>
	<u>Black Clay</u>		<u>50</u>
(2) Location: <u>1/4</u> , <u>1/4</u> , Sec. <u>36</u> T. <u>10</u> R. <u>2E</u>	<u>Blk. Clay</u>		<u>127</u>
<u>3</u> miles <u>West</u> of <u>Canton</u> (distance) (direction) (Nearest Town)	<u>Shale + Sths Sand</u>		<u>292</u>
(3) Topography: <u>Level</u> (Hilly) (Flat) (Level)	<u>Fine Sand</u>		<u>327</u>
(4) Purpose of Well: <u>Home</u> (Domestic Irrigation Municipal, Industrial, Other)	<u>Sand + Sths Shale</u>		<u>378</u>
	<u>Shale</u>		<u>410</u>
	<u>Shale + Sths Sand</u>		<u>470</u>
	<u>Shale</u>		<u>460</u>
	<u>Shale + Sths Rock</u>		<u>514</u>
	<u>Shale + Sths Silt</u>		<u>638</u>
	<u>Shale</u>		<u>657</u>
	<u>Shale + Sths Sand</u>		<u>679</u>
	<u>Shale</u>		<u>700</u>
	<u>Fine Sand</u>		<u>703</u>
	<u>Shale</u>		<u>802</u>
	<u>Shale + Silt</u>		<u>819</u>
	<u>Shale</u>		<u>900</u>
	<u>Silt</u>		<u>904</u>
	<u>Shale</u>		<u>950</u>
	<u>Shale + Sths Silt</u>		<u>950</u>
	<u>Silt + Sths Shale</u>		<u>960</u>
	<u>Fine Sand + Sths Shale</u>		<u>970</u>

Information upon completion of well:

(1) Diameter <u>2</u> inches.	
(2) Total Depth <u>970</u> feet.	
(3) Water Level <u>30</u> feet below top of ground.	
(4) Cased to <u>9.50</u> , Size <u>2"</u>	
(5) Screen: Size <u>2"</u> , Length <u>20 ft</u>	
(6) Were any formations sealed against pollution? <u>yes</u> , <u>no</u> .	

If YES depth of formation _____
 Why _____
 Drillers Remarks: _____

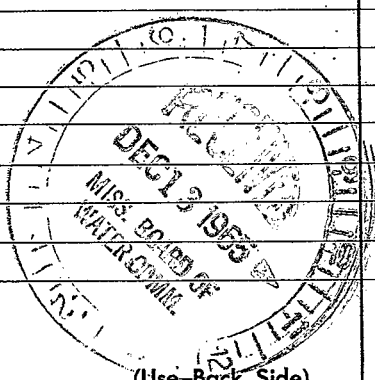

(Use Back Side)

Well No.




