

F
3-14-64 ²⁰⁰⁴

WATER WELL DRILLERS LOG

Date: 3/14, 1964, Driller: McKay County: Madison
(Name)

(1) Owner of Land: C. A. Charlie Riddell
(Name)
Canton Miss
(Address)

(2) Location: 1/4, 1/4, Sec. 10 20 R
8 miles NW of Canton
(distance) (direction) (Nearest Town)

(3) Topography: (Hilly) (Flat) (Level)

(4) Purpose of Well: Farm
(Domestic Irrigation, Municipal, Industrial, Other)

Description & Color of Materials Sand, Clay, Red Clay, Shell, etc.	Thick- ness Feet	Depth Feet
<u>Top Soil</u>	<u>0</u>	<u>5</u>
<u>Brown Clay</u>	<u>5</u>	<u>21</u>
<u>Blue Clay</u>	<u>21</u>	<u>42</u>
<u>" "</u>	<u>42</u>	<u>63</u>
<u>" "</u>	<u>63</u>	<u>105</u>
<u>Brown Clay</u>	<u>105</u>	<u>168</u>
<u>Brown Sand Clay</u>	<u>168</u>	<u>252</u>
<u>Fine Sand</u>	<u>252</u>	<u>273</u>
<u>Fine Sand</u>	<u>273</u>	<u>294</u>
<u>Fine Sand</u>	<u>294</u>	<u>315</u>
<u>med Sand</u>	<u>315</u>	<u>336</u>

Information upon completion of well:

(1) Diameter 2 inches.

(2) Total Depth 336 feet.

(3) Water Level 63 feet below top of ground.

(4) Cased to _____, Size _____.

(5) Screen: Size 007, Length 20.


(6) Were any formations sealed against pollution?
_____ yes, no.

3HP air unit

If YES depth of formation _____

Why _____

Drillers Remarks: _____

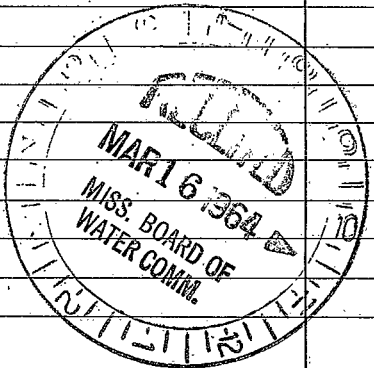

(Use Back Side)

Well No.






















