

MADISON

WATER WELL DRILLERS LOG

CODED

G-48  
Date: 7/21, 1965, Driller: M<sup>c</sup>Kay  
7-21-65

County: Madison

- (1) Owner of Land: John Anderson  
(Name)  
Center  
(Address)
- (2) Location: 7 1/4,        1/4, Sec. 23 T. 10 R. 3E,  
7 miles NE, of Center,  
(distance) (direction) (Nearest Town)
- (3) Topography:  (Hilly)  (Flat)  (Level)
- (4) Purpose of Well: Home  
(Domestic Irrigation  
Municipal, Industrial, Other)

Description & Color of Materials Sand, Clay, Red Clay, Shell, etc.	Thick- ness Feet	Depth Feet
Red clay	0	20
Blue clay	20	40
Blue clay	40	100
Fine sand	100	200
Shale	200	240
Sand	240	280
Clay -	280	300

Information upon completion of well:


- (1) Diameter 2 inches.
- (2) Total Depth 300 feet.
- (3) Water Level 77 feet below top of ground.
- (4) Cased to \_\_\_\_\_, Size \_\_\_\_\_
- (5) Screen: Size 007, Length 10
- (6) Were any formations sealed against pollution?  
\_\_\_\_\_ yes, \_\_\_\_\_ no.

If YES depth of formation \_\_\_\_\_

Why \_\_\_\_\_

Drillers Remarks: \_\_\_\_\_

CODED

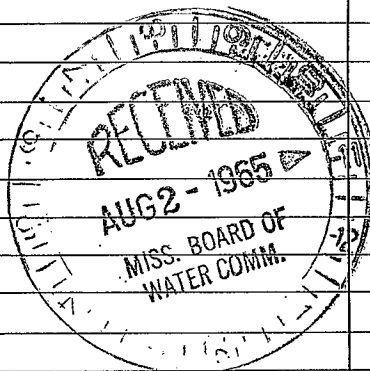

(Use Back Side)

Well No.




