


Date: 3-28, 1966, Driller: J.P. Chambers County, Madison  
3-28-66 (Name)

(1) Owner of Land: Eugene Bonster  
(Name)  
Camden Miss  
(Address)  
(2) Location: 1/4, 1/4, Sec. T R  
5 miles SW of Camden  
(distance) (direction) (Nearest Town)  
(3) Topography: X  
(Hilly) (Flat) (Level)  
(4) Purpose of Well: Domestic  
(Domestic Irrigation  
Municipal, Industrial, Other)

Description & Color of Materials Sand, Clay, Red Clay, Shell, etc.	Thick- ness Feet	Depth Feet
Red Clay	20	
Water Sand	20	
Black dirt	30	
White sand	21	
		91

Information upon completion of well:

(1) Diameter 2 inches.  
(2) Total Depth 91 feet.  
(3) Water Level 25' feet below top of ground.  
(4) Cased to 84, Size 2  
(5) Screen: Size 1/4, Length 6ft  
(6) Were any formations sealed against pollution?  
yes, X no.

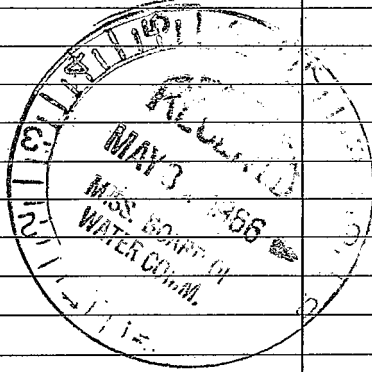

If YES depth of formation \_\_\_\_\_  
Why \_\_\_\_\_  
Drillers Remarks: 600 gal per hr

(Use Back Side)

Well No.














