

M39

10-1-65

WATER WELL DRILLERS LOG **CODED**

Date: 10/1, 1965, Driller: Forest Drilling County Madison  
 (Name)

(1) Owner of Land: Humble Oil  
 (Name)  
Jackson, Miss.  
 (Address)

(2) Location: 1/4, 1/4, Sec. 23 T9 R2E  
1/2 miles at of Canton  
 (distance) (direction) (Nearest Town)

(3) Topography:  (Level)  
 (Hilly) (Flat)

(4) Purpose of Well:  (Level)  
 (Domestic Irrigation) (Municipal, Industrial, Other)

Information upon completion of well:

(1) Diameter 4 X 2 inches.

(2) Total Depth 409 feet.

(3) Water Level 13 feet below top of ground.  
189 ft 4"


(4) Cased to 29 ft 2" Size 2"

(5) Screen: Size 2", Length 15 ft.

(6) Were any formations sealed against pollution?  
 \_\_\_\_\_ yes,  no.

Description & Color of Materials Sand, Clay, Red Clay, Shell, etc.	Thick- ness Feet	Depth Feet
Fill dirt		5
yellow clay & shale		20
Chalk & silt sand		30
yellow chalk		40
Blue Clay		61
B. clay & fine		71
Rock		72
lime shell + soft clay		82
lime shell chert & lignite		102
soft clay's & silt		123
base clay		205
shale + soft clay		225
shale		240
fine sand + silt shale		255
shale		307
soft shale		348
fine sand		378
sand + silt shale		409
fine sand		415

**CODED**

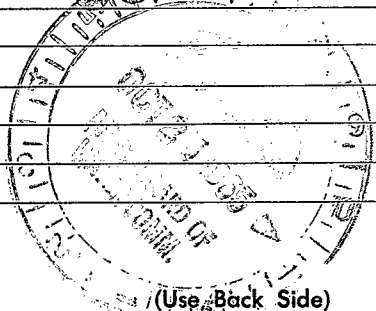

(Use Back Side)

Well No.




