

N32  
10-28-64

WATER WELL DRILLERS LOG

*Madison*  
**CODED**

Date: 10/28, 1964, Driller: Frost Drilling County: Madison  
(Name)

(1) Owner of Land: Billy Brown  
(Name)  
Centon, Miss  
(Address) 32 10 3E

(2) Location: 1/4, 1/4, Sec. S T9 R3E  
3 miles North of Centon  
(distance) (direction) (Nearest Town)  
Old Hwy 51

(3) Topography: (Hilly) (Flat) (Level)

(4) Purpose of Well: Home  
(Domestic Irrigation  
Municipal, Industrial, Other)

Description & Color of Materials Sand, Clay, Red Clay, Shell, etc.	Thick- ness Feet	Depth Feet
Brown silt		18
Red sand		26
Blue clay		61
Shale + silt		143
Fine sand		184
Sand + silt lignite		212
Shale + lignite		218
Sand shale		225
Shale + soft clay		255
Shale + silt sand		266
Sand + silt lignite		276
Med sand		304
Shale + silt silt		318
Fine sand + silt lignite		327
Fine sand + silt silt		345
Shale + silt silt		368
Blue clay		471
B. clay + silt rock		512
Soft + soft clay		576
Shale		598
Hard shale		700
Shale + silt silt		710
Shale		748
Shale + silt silt		769
Silt sand + silt shale		790
Fine sand + silt shale		832
Shale + silt silt		840
Fine sand		915

Information upon completion of well:

(1) Diameter 2 inches.

(2) Total Depth 915 feet.

(3) Water Level 50 feet below top of ground.

(4) Cased to 900, Size 2"


(5) Screen: Size 2", Length 15 ft.

(6) Were any formations sealed against pollution?  
\_\_\_\_\_ yes,  no.

If YES depth of formation \_\_\_\_\_

Why \_\_\_\_\_

Drillers Remarks: \_\_\_\_\_

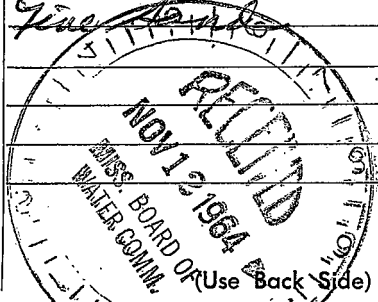

Well No.





