MADISON
T64
6-25-81
Elog # 264

MISSISSIPPI
BOARD OF WATER COMMISSIONERS
416 North State Street
Jackson, Mississippi 39201

WATER WELL DRILLERS LOG

6-25 1981 — date well completed
THOMAS — firm name
MADISON — county well located

LANDOWNER: DRed PORter
P.O. 12463
JACKSON, MS.
(mailing address)

WELL LOCATION:
sec. 31 T 8 N/S R 3 E/W
3 1/2 miles NE of MADISON
(distance) (direction) (nearest town)

WELL PURPOSE:
(home, irrigation, municipal, industrial)

WELL COMPLETION DATA:
(1) diameter (inches) 4
(2) total depth (feet) 604
(3) static water level (feet) 130 below/above top of ground.
(4) casing PVC (material), 574 (depth),
4X2 (size) if telescope see back.
(5) screen 30 (length), 574 (depth to top)
2 (size), 10 slot PVC (material)
(6) pump 1 1/2 (HP) 16 (yield gpm)
Elec (type power)
(7) electric log ~~No~~ yes (yes or no) See an Elog Sec. 32 8N 2E (organization running log)
(8) how well bottom plugged POINT

DRILLERS REMARKS:

description of formations encountered	from	to
Clay	0	38
Grey Chalk	38	250
Little Shell + Sand	280	
Fine Sand Stks		
Grey Chalk		386
Fine Sand	386	415
Grey Chalk	415	430
Stks Green Sand +	430	440
Chalk Sand	440	458
Sand		
Grey Chalk Sand	458	538
Fine Sand Stks		
Sand	538	605
Course At Bottom		

AUG 1981 RECEIVED

If well telescopes please sketch and show depths.

GROUND LEVEL

If more than one screen, show locations of each on sketch.

164

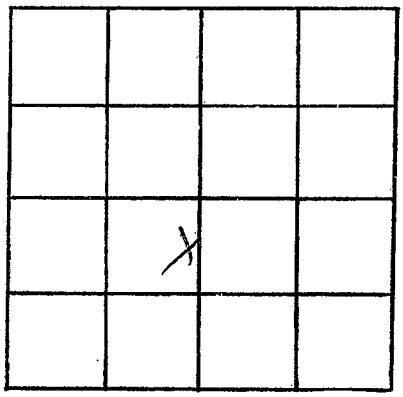

SECTION 31

Please indicate well location X.

ADDITIONAL INFORMATION