Madison
W 48
2-20-70

MISSISSIPPI
BOARD OF WATER COMMISSIONERS
416 North State Street
Jackson, Mississippi 39201

CODED

WATER WELL DRILLERS LOG

Feb. 20 1970 N. E. Thompson Madison
date well completed — firm name — county well located

LANDOWNER: J. B. Walker
Jackson Miss.
(mailing address)

WELL LOCATION:
sec. 33 T 7 (N) R 2 (E)

(distance) miles (direction) of (nearest town)

WELL PURPOSE: Service station
(home, irrigation, municipal, industrial)

WELL COMPLETION DATA:

(1) diameter (inches) 4" x 2"

(2) total depth (feet) 590"

(3) static water level (feet) 158 below ~~above~~ top of ground.

(4) casing Plastic (material), 4" 220' 2" 473 (depth),
4" @ 2" (size) if telescope see back.

(5) screen 10' (length), 473' (depth to top)
2" (size), Plastic (material)

(6) pump 1 (HP) 15 (yield gpm)
Sub. (type power)

(7) electric log yes (yes or no)
M. S. A. (organization running log)

(8) how well bottom plugged B/W

DRILLERS REMARKS: Drilled one well & lost it

description of formations encountered	from	to
Clay.	0	20
Yagoo Clay	20	350
Moodys Branch	350	380
Cockfield	380	590

CODED

MAR 6 - 1970
MISS. BD. OF WATER COMM.

If well telescopes please sketch and show depths.

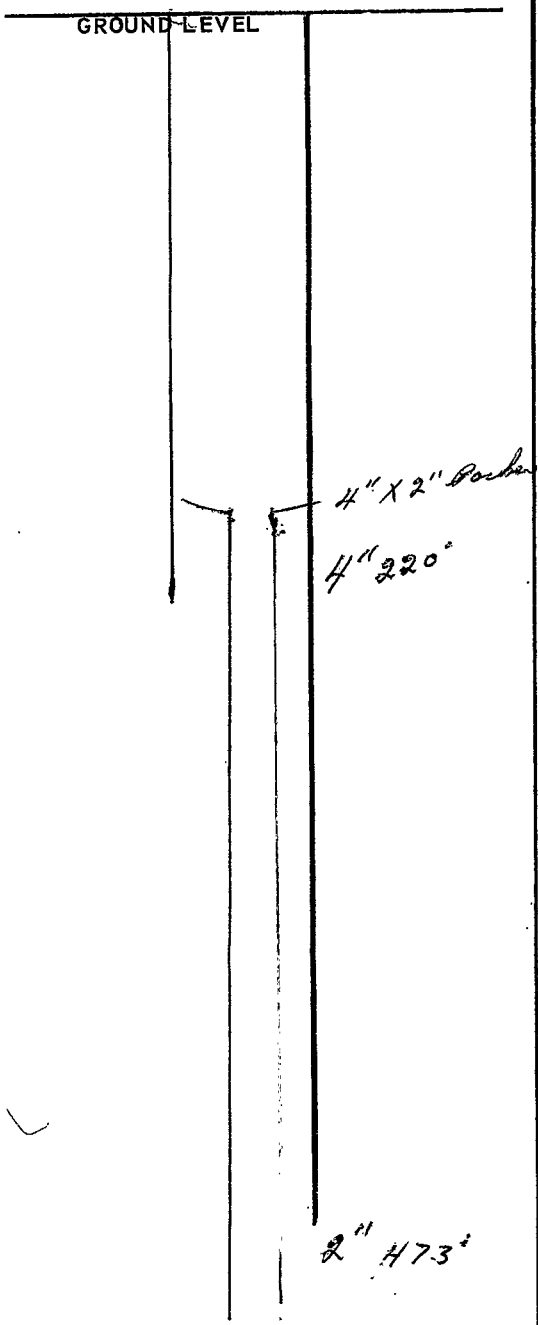

If more than one screen, show locations of each on sketch.

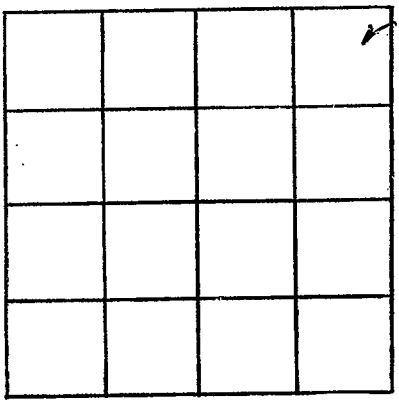

SECTION 33

Please indicate well location X.

ADDITIONAL INFORMATION