MADISON
W 54
11-71

MISSISSIPPI
BOARD OF WATER COMMISSIONERS
416 North State Street
Jackson, Mississippi 39201

DEC 3 1971

CODED

WATER WELL DRILLERS LOG OF

19 JOHN DAVIS MADISON
date well completed — firm name — county well located

LANDOWNER: Guy Bennet
MADISON
(mailing address)

WELL LOCATION:
sec. 7 T 7 (N) S R 2 (E) W
1/2 (distance) miles NW (direction) of MADISON (nearest town)

WELL PURPOSE: Home
(home, irrigation, municipal, industrial)

WELL COMPLETION DATA:
(1) diameter (inches) 2
(2) total depth (feet) 604
(3) static water level (feet) 198 below ~~above~~ top of ground.
(4) casing Gal (material), 604 (depth), _____ (size) If telescope see back.
(5) screen 20 (length), 584 (depth to top)
2" 7 slot (size), SS (material)
(6) pump 5 Air (HP) 12 (yield gpm)
Elec (type power)
(7) electric log _____ (yes or no)
_____ (organization running log)
(8) how well bottom plugged Pen

DRILLERS REMARKS: _____

description of formations encountered	from	to
Red Clay & Sand	0	38
Blue Clay	38	391
Muddy Branch	391	411
Blue Clay	411	451
Fine Sand	451	491
Blue Clay	491	511
Fine Sand	511	531
Sand Break	531	544
Good Water Sand	544	604

CODED

If well telescopes please sketch and show depths.

GROUND LEVEL

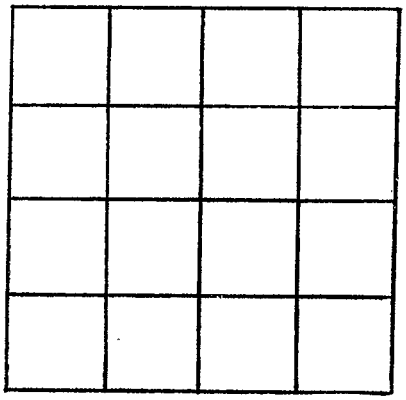

SECTION _____

Please indicate well location X.

ADDITIONAL INFORMATION

If more than one screen, show locations of each on sketch.