Marion
B8
1-20-68
M.G.S.

CODED CODED CODED CODED CODED CODED CODED

MISSISSIPPI BOARD OF WATER COMMISSIONERS
416 North State Street
Jackson, Mississippi 39201

WATER WELL DRILLERS LOG

1-20 1968 Griner Drilling Co. Marion
date well completed firm name county well located

LANDOWNER: Foss Water Ass'n.

Foss, Miss
(mailing address)

WELL LOCATION:
sec. 27 T 5 N (N/S) R 19 W (E/W)
10 miles N of Columbia
(distance) (direction) (nearest town)

WELL PURPOSE: Municipal
(home, irrigation, municipal, industrial)

WELL COMPLETION DATA:

(1) diameter (inches) 8"
(2) total depth (feet) 800
(3) static water level (feet) 70' below/above top of ground.
(4) casing Steel (material), 695' (depth), _____ (size) if telescope see back.
(5) screen 40' (length), 800' (depth to top), 6" (size), Stainless Steel (material)
(6) pump 20 (HP) 125 (yield gpm) Electric (type power)
(7) electric log Yes (yes or no) MES (organization running log)
(8) how well bottom plugged Back Wash Valve

DRILLERS REMARKS:

description of formations encountered	from	to
Top Soil	0	2
Sand	2	40
Clay	40	60
Sand	60	134
Clay	134	150
Coarse Sand	150	435
Clay	435	596
Sand w/Clay Breaks	596	698
Sand	698	728
Clay	728	770
Sand	770	800
Clay w/Small Sand Breaks	800	985

CODED CODED CODED CODED

JAN 21 1969
MISS. BD. OF WATER COMM.

2

If well telescopes please sketch and show depths.

GROUND LEVEL

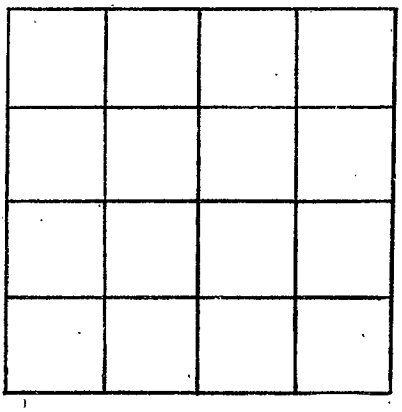

SECTION 27

Please indicate well location X.

ADDITIONAL INFORMATION

If more than one screen, show locations of each on sketch.