MISSISSIPPI DEPARTMENT OF ENVIRONMENTAL QUALITY
Bureau of Land and Water Resources

P. O. Box 10631
Jackson, MS 39289-0631
WATER WELL DRILLERS LOG

COUNTY WELL LOCATED: Marion	
WELL NUMBER: B42	CODED: ✓
PERMIT NUMBER	
NAME OF DRILLING FIRM: Griner Drilling Service, Inc.	
DATE WELL COMPLETED: 06-30-95	

NAME & MAILING ADDRESS OF LANDOWNER
Georgia Pacific Corporation
P.O. Box 563
Columbia, MS 39429

WELL LOCATION: SEC SE¼,SW¼ 35 TOWNSHIP 5 [N] S RANGE 19 [E] W

DISTANCE 7 Miles DIRECTION N NEAREST TOWN Columbia of

OTHER LANDMARK: On Highway 13

WELL PURPOSE: Home, Irrigation, Municipal, Industrial, Fish Pond, etc.: Wet roads

PUMP DATA

PUMP TYPE (Circle One): [Submersible,] Turbine, Jet Flowing Well, Other (Describe) _____

POWER TYPE (Circle One): [Electric,] Tractor, Diesel, Gasoline, Butane, Other (Describe) _____ H/P 15

Pump Capacity (GPM)	No. of Stages	Setting Depth
120	5	126 FT.

PUMP TEST

Well yielded 120 GPM with a drawdown of 12 ft. after 1 hours of pumping

WELL DATA

Well Depth	Casing Diameter (In.)	Casing Length (Ft.)
220'	6	180

Type of Casing	Hole Depth	Depth to Static Water Level
steel	254'	35

TYPE OF COMPLETION: (Circle One or More): Gravel Packed, Underreamed, Telescoped, [Natural Development,] Open Hole, Other (Describe) _____

Top of Lap Pipe or Reduction in Casing: 148 FEET

IF TELESCOPED OR MORE THAN ONE SCREEN: USE BACK PAGE

LOG DATA

TYPE OF LOG RUN (Circle One): No Log Run, [Electric, Gamma Ray,] Density, Sonic, Neutron, Other (Describe) _____

Name of Organization Running Log: Griner Drilling Service, Inc.

GEOLOGIC DATA (Office Use Only)

Surface Elev.	Geologic Unit	Unit Thickness	Depth to Top
Subs. SWL	Date	Analysis	Aquifer Test

Driller's Remarks

SCREEN DATA

Diameter - Inches	Length - Feet	Slot Size - Inches
4	30	.008

Screen Type	Depth to Bottom - Feet
Rod Base	220

DESCRIPTION OF FORMATIONS ENCOUNTERED	FROM	TO
Sand & Gravel	0	239
Clay	239	254

FORMATIONS (Continued)	FROM	TO

RECEIVED
JUL 28 1995
Dept. of Environmental Quality
Office of Land & Water Resources

IF MORE SPACE IS NEEDED, USE BACK

If well telescopes please
sketch and show depths.

GROUND LEVEL

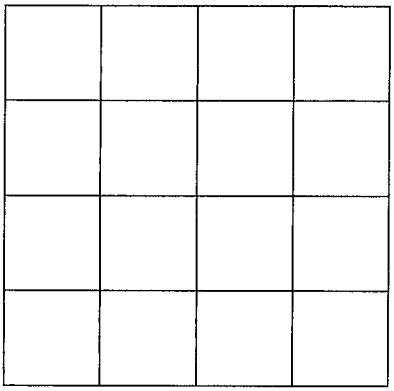

SECTION _____

Please indicate well location X.

ADDITIONAL INFORMATION

If more than one screen,
show location of each on sketch.