G 46
marion
2/5/75

MISSISSIPPI
BOARD OF WATER COMMISSIONERS
416 North State Street
Jackson, Mississippi 39201

CODED

WATER WELL DRILLERS LOG

2-5 1975 Carver-Cino Marion
date well completed firm name county well located

LANDOWNER: Dewitt Speights
Rt. 7, Box 176 Columbia
(mailing address)

WELL LOCATION:
sec. 1 T 4 N ~~S~~ R 18 E ~~W~~
7 (distance) miles N (direction) of Columbia (nearest town)

WELL PURPOSE: Home
(home, irrigation, municipal, industrial)

WELL COMPLETION DATA:

(1) diameter (inches) 2"
(2) total depth (feet) 70
(3) static water level (feet) 58 below above top of ground.
(4) casing PVC (material), 60 (depth), 2" (size) if telescope see back.
(5) screen 10' (length), 60 (depth to top), 2" (size), PVC (material)
(6) pump 1 (HP) (yield gpm) elec (type power)
(7) electric log NO (yes or no)
(organization running log)
(8) how well bottom plugged B.W. Valve

DRILLERS REMARKS:

description of formations encountered	from	to
Top Soil	0	1
Clay	1	49
Sand	49	70

RECEIVED
JUN 6 1975
MISS. BD. OF WATER COMM.

If well telescopes please sketch and show depths.

GROUND LEVEL

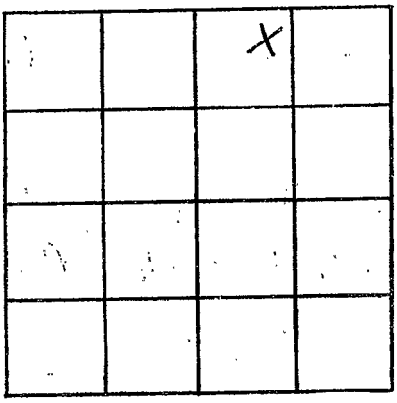

SECTION 5

Please indicate well location X.

ADDITIONAL INFORMATION

If more than one screen, show locations of each on sketch.